


Section 32 Township 34 Range 34W

Well No. #1 Engel

Company Plains Natural Gas

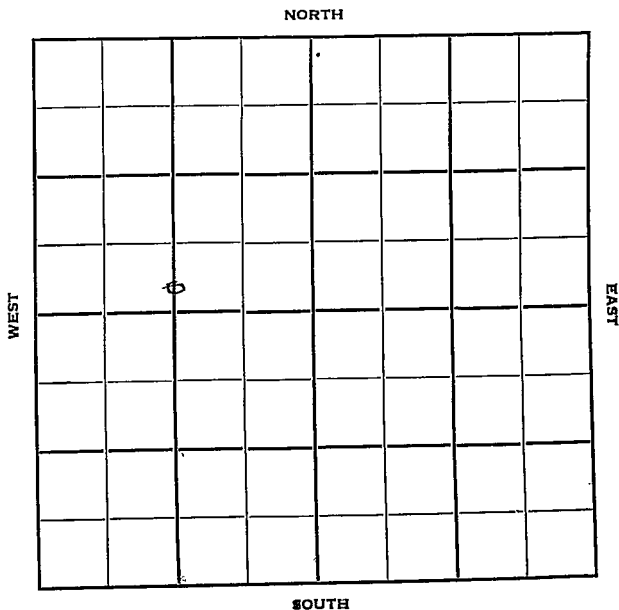

Seward

KANSAS

Sec. 32 Twp. 34 R. 34W

Well No. #1 Engel Farm

Plains Natural Gas Company

Contractor

Hugoton Pool


2440' Ft. from N. Line

Ft. from S. Line

Ft. from E. Line

1320' Ft. from W. Line

C S L S $\frac{1}{2}$ NW

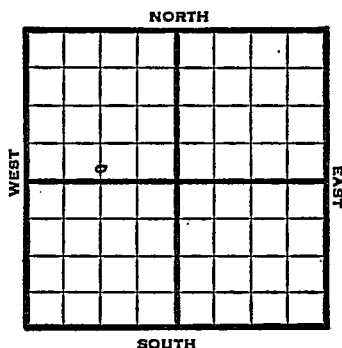

1950

Elev. 2937' REPORT

10/4

Spud 9-30-50
10" @ 657'
WOC

11/15

10" @ 657
TD 2759
7" @ 2743
Hol 2565 Her 2627
Krider 2659 Win 2739
282/2586-2733, 48/2660-68, 60/2635-45
30/2625-33
19000 A
Comp 2,296,000 gas
TD 2759
Completed

COMPLETED

County Seward State KansasSec. 32 (Blk. Twp.) 34 (Sur. Rge.) 3 4W Map No.Operator Plains Natural GasWell No. 1 Farm EngelElev. 2937 Location C S I. S $\frac{1}{2}$ NW


2440 Ft. From N Line NW1320 Ft. From W Line Quarter1st. Report OCT 4 1950

Completion

Remarks

Spudding Date 9-30-50Drlg. Data Hugoton Pool10" @ 657 WOC

J. E. TYRA

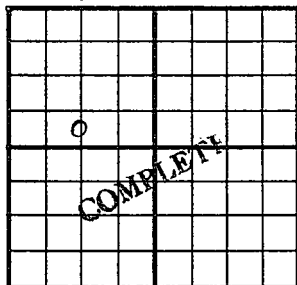County Seward State KansasSec. 32 (Blk.) 34 (Sur.) 34W Map No. Operator Plains Natural GasWell No. 1 Farm EngelElev. 2937 Location C S L S $\frac{1}{2}$ NW2440 Ft. From N Line NW1320 Ft. From W Line Quarter1st. Report Completion NOV 15 1950Remarks Hugoton PoolSpudding Date 9-30-50Drlg. Data Gas well TD 275910" @ 657 TD 2759 7" @ 2743Hol. 2565 Her. 2627 Krider 2659Win. 2739 282/ 2686-2733 48/ 2660-6860/ 2635-45 30/ 2625-33 19000 AComp. 2,296,000 gas