


Section 32 Township 34 Range 43WWell No. #1 WikerCompany Musgrove Pet.

NORTH

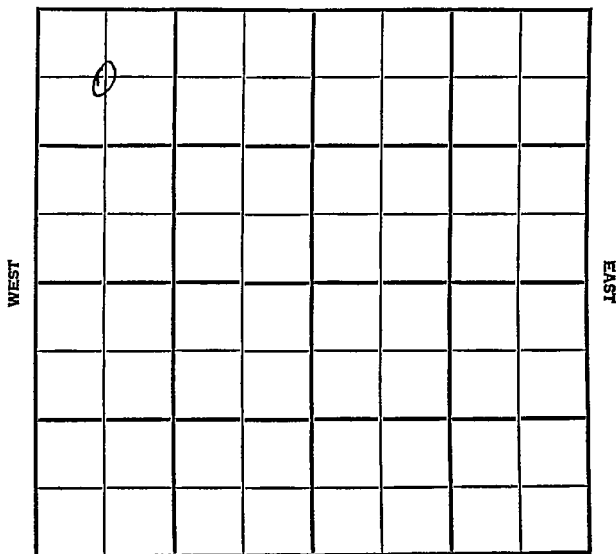

SOUTH

# Morton KANSAS

|      |      |     |
|------|------|-----|
| SEC. | TWP. | R.  |
| 32   | 34   | 13W |

WELL NO.

1 Wiker FARM  
COMPANY

Musgrove Petr.  
CONTRACTOR


Co.Tools

Greenwood Pool  
660 Ft. from N. Line

Ft. from S. Line

Ft. from E. Line

660 Ft. from W. Line

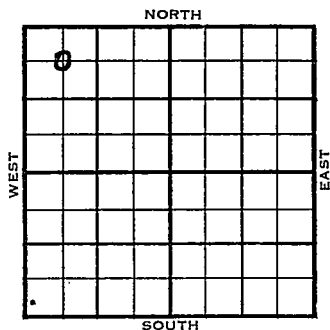

C NW NW

|      |                    |        |
|------|--------------------|--------|
| 1955 | ELEVATION<br>3542' | REPORT |
|------|--------------------|--------|

3/2 Location  
4/20 Spud 3-3-55 Oil well TD 4310  
8" @ 1242 Morrow 4096 Puddy 4198  
TD 4310 5" @ 4309 Co 56/4202-16  
gas in 1 min. F/oil in 5 min.  
F/22 BOPH Comp. BHB F/1257 BOPD  
**COMPLETED**

County **Morton** State **Kansas**

Sec. **32** (Blk. Twp.) **34** (Sur. Rge.) **43W** Map No.

Operator **Musgrove Pet.**

Well No. **1** Farm **Wiker**

Elev. Location **C NW NW**



**660** Ft. From **N** Line **NW**

**660** Ft. From **W** Line **Quarter**

Ist. Report **MAR 2 1955**

Completion

Remarks

**Co. tools**


Spudding Date

Drlg. Data **Greenwood Pool**

**Location**

**FABEN GILSTRAP**

County Morton State Kansas  
 Sec. 32 (Blk. 1 Twp.) 34 (Sur. 43W Rge.) Map No.  
 Operator Musgrove Pet.  
 Well No. 1 Farm Wiker  
 Elev. 3542 Location C NW NW

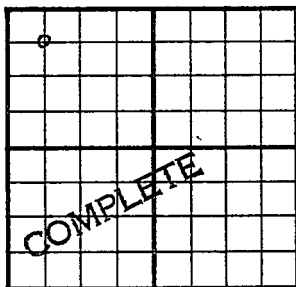

660 Ft. From N Line NW  
660 Ft. From W Line Quarter  
 1st. Report  
 Completion APR 20 1955  
 Remarks Greenwood Pool  
Co. tools  
 Spudding Date 3-3-55

Drlg. Data Oilwell TD 4310  
8" @ 1242 Morrow 4096 Purdy 4198  
TD 4310 5" @ 4309 CO 56/ 4202-16  
gas in 1 min. F/ oil in 5 min.  
F/ 22 boph Comp. BHB F/ 1257 bopd