


DX 78-1 Morton

KANSAS

Section 32 Township 34 Range 43W

Well No. #1³² Scott

Company Panhandle Eastern

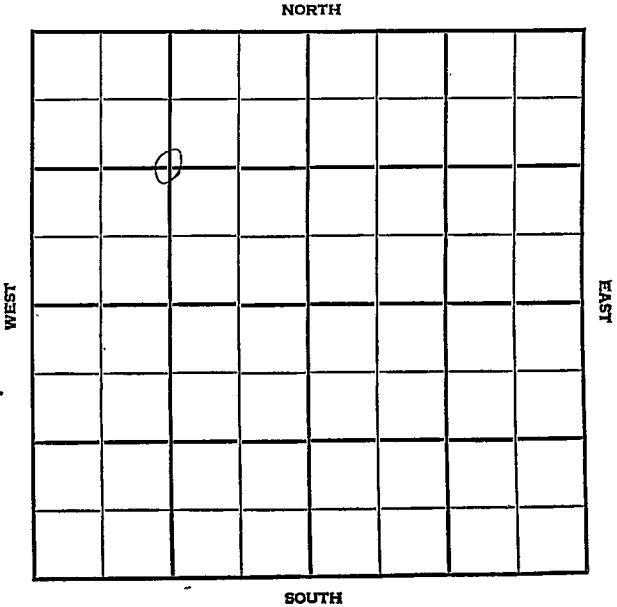

Morton

SEC. 32	TWP. 34	R. 43W
------------	------------	-----------

 WELL NO. ~~#1~~-32
~~#1~~ Scott

FARM

COMPANY

Panhandle Eastern

CONTRACTOR

Garvey

Interstate


_____ FT. FROM N. LINE

_____ FT. FROM S. LINE

_____ FT. FROM E. LINE

_____ FT. FROM W. LINE

C NW/4

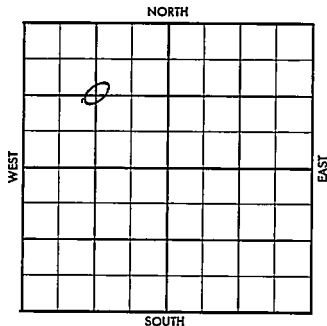

ELEVATION

REPORT

1956

5-29

 Comm. 5-23-56
 Drlg. 912
COMPLETED

County Morton Elev. _____
 Sec. 32 Twp. 34 Rge. 13W
 Company Panhandle Eastern
 Farm Name Scott No. 1

TOPS	DEPTH	LOG	DATUM
Anh.			
Tr.			
H.			
Tr.			
Dg.			
BL.			
L.			
K.C.			
B.K.C.			
Ce.			
C.			
M.			
M.			
K.			
Mz.			
Mo.			
V.			
S.			
S.			
A.			
R.			
PE.			
G.			
T.D.			

Loc. in Sec.

C NW/4

Geol.

Contr.

Garvey

Pool

Interstate

FIRST REPORT

MAY 29 1956

Date Comm. 5-23-56

drilg. 912

25

CORRECTION

County NortonElev. 3540Sec. 32Twp. 34Rge. 43WCompany Panhandle EasternFarm Name ScottNo. 1-32

TOPS	DEPTH	LOG	DATUM	Loc. in Sec.
Anh.				C NW/4
Tp.				
H.				
Tr.				
Dg.				
Bl.				
L.				
K.C.				Geol.
B.K.C.				Contr.
Ce. <u>Morr</u>		<u>4114</u>		<u>Garvey</u>
C. <u>sd</u>		<u>4121-35</u>		
M.				Pool
M.				<u>Interstate</u>
K.				
Mz.				
Me.				
V.				
S.				
S.				
A.				
R.				
Pe.				
G.				
TD.	<u>4180</u>	<u>4180</u>		

COMPLETE

SEP 12 '56

Date Comm. 5-23-56drill 912 JUN 6 '56 8¹⁸ 1247/597

DST 2856-2900 (80) 925 (30)

Loc 90' GCM FP 120-120 BHP

460 (20) 43483 JUN 13 '56

DST 4116-80 (22) 925 (1 1/2) 625,700

MCF Loc 75' GCM FP 750-870

BHP 1320 (40) ATP 4180- Schl

5 1/2' 4178/800 SX

PF 60/ 4123-33 62 11,175 MCF

15T

32-34-43

CNW/4

JUN 20 '56 1/2 FR2C 9a 26.600 MC
 PB 2920 PF 2881-88 PF 2870-88
 A CTSTM SQd. CO 36/2846
 -52 24/2854-58 ~~36/2854-58~~
 A 36/2864-70 A 556 SQd.
 JUN 27 '56 CO 30/2818-23 42/
 2800-07 TST 556 + 12 GWP
 A TST 300 GWP h no/g.
 SQd JUL 3 '56 CO ^{PB} TD Rn9 T69.
 JUL 11 '56 JUL 18 '56 JUL 25 '56 /2785-94
 36/2773-79 556 A TST 200
 MCFG + 250 GWP h SQd. CO
 4139P AUG 1 '56 AUG 8 '56 AUG 15 '56 AUG 22 '56
 AUG 29 '56 SEP 5 '56 SEP 12 '56 C81 0P
 FLW 13.700 MCFG

32-34-43

CNW/4