Morton **KANSAS**

SECTION 32 TOWNSHIP 34 RANGE 42 W

WELL NO. #1 Craver

COMPANY Colorado O & G

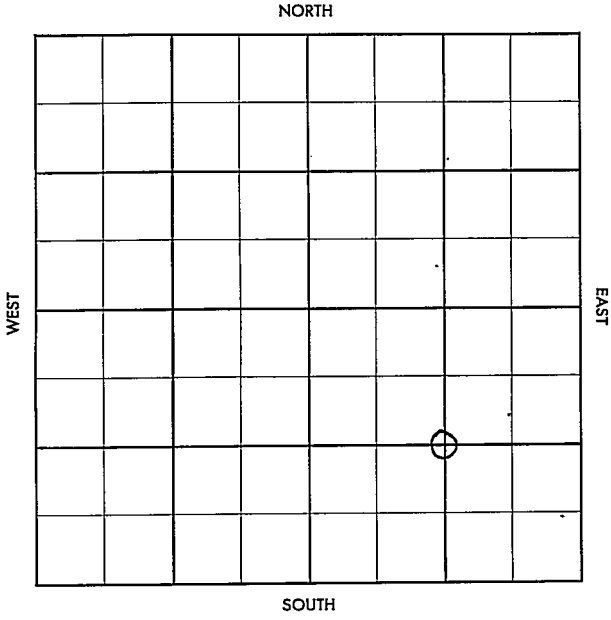

FORM 504-3 SUNRAY

Morton KANSAS

SEC.	TWP.	R.
32 - -	34	42W

WELL NO.

#1 Craver FARM

COMPANY

Colorado O&G

CONTRACTOR

Holm Drlg.

Taloga

_____ Ft. from N. Line

_____ Ft. from S. Line

_____ Ft. from E. Line

_____ Ft. from W. Line

C SE/4

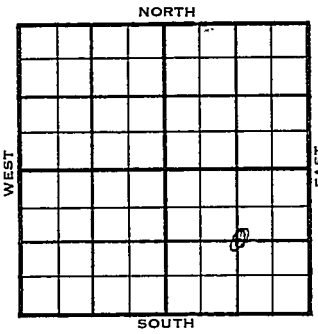

1956	ELEVATION REPORT
1-18	Comm. 1-14-56 Lost Circ. @ 469

DX-78

FORM 513 REV. SUNRAY

County Norton Elev.

Sec. 32 Twp. 3S Rge. 42W

Company Colorado O & G

Farm Name Craver No. 1

TOPS	DEPTH	LOG	DATUM
Anh.			
T.P.			
H.			
Tr.			
Dg.			
B.L.			
L.			
K.C.			
B.K.C.			
Ce.			
C.			
M.			
M.			
K.			
Mr.			
Mo.			
V.			
S.			
S.			
A			
R.			
P€.			
G.			
T.D.			

Loc. in Sec. C SE/4

Geol.

Contr. Holm Drlg.

Pool Taloga

JAN 18 '56

FIRST REPORT

Date Comm. 1-14-56

lost circ. @ 469

Co. Lse. No. Sec. T. R.

JAN 2 3 1956

R. G.

FORM 513 REV. SUNRAY

County: Morton — Elev. 3546 gr.

Sec. 32 — Twp. 34 — Rge. 42W

Company: Colorado O & G

Farm Name: Craver — No. 1

TOPS	DEPTH	LOG	DATUM
Ash. W26		2659	
Tp. [illegible]		2760	
H. Elm		2888	
Tr. TP		2969	
Bg. Le Camp		3100	
Bl.			
L.			
R.C.			
B.C.			
Cc.			
C.			
M.			
M.			
K.			
Mr.			
Mo.			
V.			
S.			
S.			
A.			
R.			
Pc.			
e.			
TD	3121		

Loc. in Sec. C SE/4

Geol.

Contr. Holm Drlg.

Pool Taloga

COMPLETE

Date Comm. 1-14-56

FEB 15 1956

lost circ. @ 469 JAN 25 '56 5½ @ FEB 1 '56

5½ 3119/200 ca 3090 52/3061-74 16/3045-49 16/3023-27 & 25 Gwph no gas SQd. FEB 8 '56 ca 48/2972-80 36/2984-3000 (A) ga 1,940MCF tica Gwph PB 2962 42/2929-46 18/2922-25 48/2911-19 54/2898-2907 (B) ga 4,330MC

CO 3010 ga 3,900 MCF
S.I. FEB 15 '56 72-20 14,400
MCF (wet) SIP 410 #

R. G.
FEB 27 1956