


Map No. KANSAS Sec. 32 Twp. 34 R. 38

Well No. 1- Barrow Farm

Argus Inc Company

NORTH

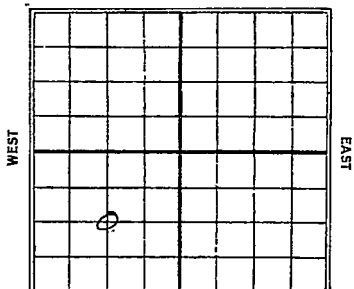

Ft. from N. Line

1320 Ft. from S. Line

Ft. from E. Line

1320 Ft. from W. Line

1930

SOUTH

Date

REPORT

4/16	Loc.
4/23	Rigging up.
4/30	Log. 600'
5/7	" 1000'
5/14	" 2287'
5/21	Rust 2483'
5/28	—
6/4	—
6/11	Sand 2628 1019
	2750' 344 gas
6/18	Sand 2628 2900
	TO 2900
	5 M gas
	Comp.


Map No. KANSAS Sec. 32 Twp. 34 R. 38W

Well No. 1 Barrows

Argus Gas Company

Contractor

SECTION PLAT

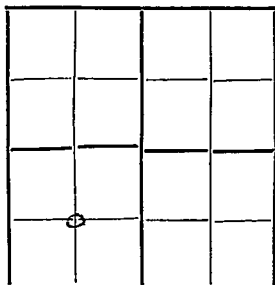

.....Ft. from N. Line

1320 Ft. from S. Line

.....Ft. from E. Line

1320 Ft. from W. Line

FIRST REPORTS :

Location.....

Rig up.....

Drilling and Remarks:

RECORD

Cased.....in.,ft.

Sand.....

Gas.....

Oil.....

Total Depth.....

PRODUCTION

1st 24 hrs. Nat.....

1st 24 hrs. after shot.....

Gas.....Cu. Ft.

Dry Hole.....

Abandoned.....

Date

APR 16 1930

S. J. LEWIS Scout

*no more
no small items*

Returned	_____
Cards	_____ <i>CP</i>
Tracing	_____ <i>X</i>
France Map	_____ <i>X</i>
Scarborough Map	_____ <i>X</i>
Moody Map	_____ <i>X</i>
Scarborough Flat Book	_____
Moody Flat Book	_____

Map No. **KANSAS** Sec. 22 Twp. 34 R. 38WWell No. 1 BarrowsArgus Gas Company


Contractor

SECTION PLAT

Ft. from N. Line

1820 Ft. from S. Line

Ft. from E. Line

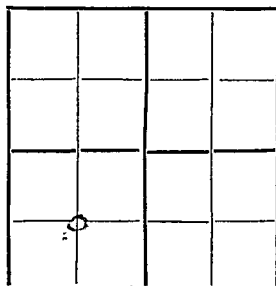1820 Ft. from W. Line

COMPLETED

Location

Rig up

Drilling and Remarks:

5 M Gas

RECORD

Cased _____ in., _____ ft.

Sand 2628 - 2900

Gas _____

Oil _____

Total Depth 2900

PRODUCTION

1st 24 hrs. Nat. _____

1st 24 hrs. after shot _____

Gas _____ Cu. Ft.

Dry Hole _____

Abandoned _____

Date

JUN 18 1930S. J. LEWIS Scout

no answer
no work

Returned	
Cards	
Tracing	X
France Map	X
Scarborough Map	X
Moody Map	X
Scarborough Plat Book	X
Moody Plat Book	