

6-34-33W
175-20298

KANSAS DRILLERS LOG

S6 T. 34S R. 33 W
Loc. 1980' FNL, 1320' FEL NE/4
County Seward

API No. 15 — 175 — 20298
County Number

Operator
Cities Service Oil Company

Address
3545 N. W. 58th Street, Oklahoma City, Okla. 73112


Well No. 2 Lease Name Fincham A

Footage Location
1980 feet from (N) ~~XX~~ line 1320 feet from (E) ~~XX~~ line

Principal Contractor Lohmann & Johnson Geologist ----

Spud Date 8-24-76 Total Depth 6420' P.B.T.D. ----

Date Completed 9-11-76 Oil Purchaser ----

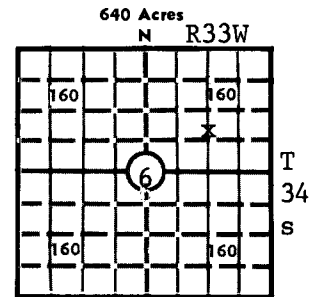

Locate well correctly
Elev.: Gr. 2858'
DF 2866' KB 2867'

CASING RECORD

Report of all strings set— surface, intermediate, production, etc.

Purpose of string	Size hole drilled	Size casing set (in O.D.)	Weight lbs/ft.	Setting depth	Type cement	Sacks	Type and percent additives
Surface	12-1/4"	8-5/8"	24#	1604'	Class H	650	Cemented w/700'sx Class H w/3% CaCl.
	Cement circulated:		50 sx.				

LINER RECORD

PERFORATION RECORD

Top, ft.	Bottom, ft.	Sacks cement	Shots per ft.	Size & type	Depth interval
---	---	----	---	----	----

Size	Setting depth	Packer set at
---	---	----

ACID, FRACTURE, SHOT, CEMENT SQUEEZE RECORD

Amount and kind of material used	Depth interval treated
N/A	N/A

INITIAL PRODUCTION

Date of first production <u>Dry Hole - No Test Conducted.</u>	Producing method (flowing, pumping, gas lift, etc.)
RATE OF PRODUCTION PER 24 HOURS	Oil <u>----</u> bbls. Gas <u>----</u> MCF Water <u>----</u> bbls. Gas-oil ratio <u>----</u> CFPB
Disposition of gas (vented, used on lease or sold)	Producing interval (s)

INSTRUCTIONS: As provided in KCC Rule 82-2-125, within 90 days after completion of a well, one completed copy of this Drillers Log shall be transmitted to the State Geological Survey of Kansas, 4150 Monroe Street, Wichita, Kansas 67209. Copies of this form are available from the Conservation Division, State Corporation Commission, 3830 So. Meridian (P.O. Box 17027), Wichita, Kansas 66217. Phone AC 316-522-2206. If confidential custody is desired, please note Rule 82-2-125. Drillers Logs will be on open file in the Oil and Gas Division, State Geological Survey of Kansas, Lawrence, Kansas 66044.

Operator

Cities Service Oil Company

DESIGNATE TYPE OF COMP.: OIL, GAS, DRY HOLE, SWD, ETC.:

Well No. 2

Lease Name Fincham "A"

Dry Hole

S 6 T34S R33 X33 W

WELL LOG

Show all important zones of porosity and contents thereof; cored intervals, and all drill-stem tests, including depth interval tested, cushion used, time tool open, flowing and shut-in pressures, and recoveries.

SHOW GEOLOGICAL MARKERS, LOGS RUN, OR OTHER DESCRIPTIVE INFORMATION.

FORMATION DESCRIPTION, CONTENTS, ETC. TOP BOTTOM NAME DEPTH

FORMATION DESCRIPTION, CONTENTS, ETC.	TOP	BOTTOM	NAME	DEPTH
Red Bed	0	1042	Ran DST #1 Morrow S-3	5952-6012;
Sand	1042	1227	Ran DST #2 Lower Chester	6288-6350'
Red Bed & Shale	1227	1353	DST #2A Lower Chester	6264-6350'
Shale	1353	1592	DST #3 Admire	3930-3998'
Anhydrite	1592	1605		
Shale	1605	1605		
Shale & Lime	1605	3900		
Shale & Lime	3900	4095		
Lime & Shale	4095	4220		
Lime & Shale	4220	4365		
Lime	4365	4480		
Lime & Shale	4480	4725		
Shale & Lime	4725	5103		
Shale & Lime	5103	5383		
Lime & Shale	5383	5655		
Lime	5655	5780		
Lime & Shale	5780	6012		
Lime & Sand	6012	6024		
Sand, Shale & Lime	6024	6095		
Lime	6095	6420		
Lime	6420	6420		
T.D.				

USE ADDITIONAL SHEETS, IF NECESSARY, TO COMPLETE WELL RECORD.

Date Received

H. E. Massey

Signature

Operations Manager

Title

September 15, 1976

Date