

16-34-33W



WELL LOG BUREAU—KANSAS GEOLOGICAL SOCIETY
508 East Murdock Wichita, Kansas

Company - CITIES SERVICE OIL CO.
Farm - Salley "C" No. 1

SEC. 16 T. 34 R. 33W
NE NE NE SW
100' S. & 100' W. of Center

Total Depth. 2805
Comm. 1-30-50 Comp. 2-12-50
Sector Treated.
Director. Corbett & Barbour Drlg. Co.
Date. 6-23-51

County. Seward
KANSAS

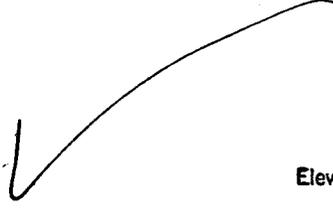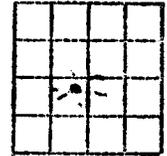

CASING:
8 5/8" 680' cem. w/300 sx
5 1/2" 2804' cem. w/700 sx

Elevation. 2867

Production. 15,100,000 gas

Figures Indicate Bottom of Formations.

clay	104
sand	112
clay & shells	177
sand & gravel	185
clay	203
sand & gravel	330
sand	420
shale & shells	630
red bed	895
anhydrite	930
red bed & shale	1560
anhydrite	1630
red rock & anhydrite	1780
shale & shells	2060
shale & lime	2200
lime & shale	2355
shale & lime	2455
lime	2520
anhydrite, lime & shale	2580
lime	2805
Total Depth	

Tops:

Herington	2608
Upper Krider	2633
Lower Krider	2663
Winfield	2720
Upper Ft. Riley	2775

Perf:

25 shots	2610-15
30 "	2634-40
150 "	2666-96
20 "	2702-06
100 "	2720-40

S.I.P. 413.2#