


Section 33 Township 34 Range 12W
Well No. #1 Blanche Sterling Unit
Company Atlantic-Zenith, Magnolia

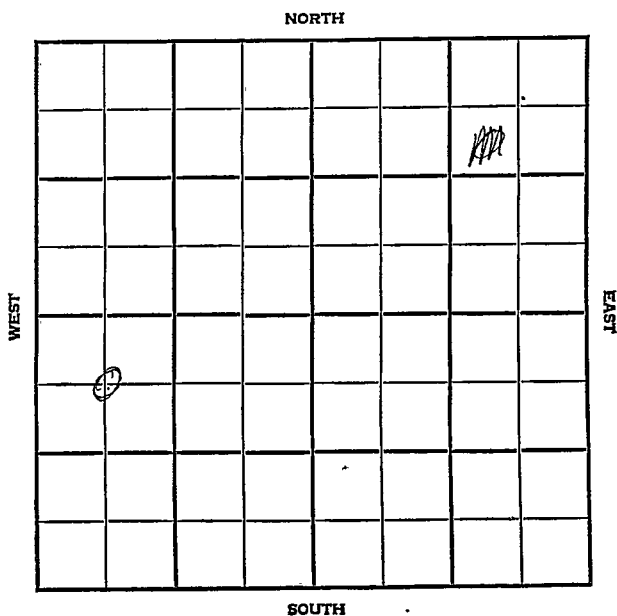

County Barber Elev. _____
Sec. 33 Twp. 34 Rge. 12W
Company Atlantic-Zenith, Magnolia
FarmName Blanche Sterling Unit No. 1

TOPS	DEPTH	LOG	DATUM
Anh.			
Tr.			
H.			
Tr.			
Dg.			
Bl.			
L.			
K.C.			
B.K.C.			
Ce.			
C.			
M.			
M.			
K.			
Mz.			
Mo.			
V.			
S.			
S.			
A.			
R.			
Pe.			
G.			
T.D.			

Loc. in Sec. C NW SW
Geol. _____
Contr. Musgrove Tools
Pool Hardtner

FIRST REPORT
NOV 14 55
0

Date Comm. RURT
36
105 VOV
51 6

Co.
No.
Sec.
T.
R.

County Barber Elev. 1465
 Sec. 33 Twp. 34 Rge. 12W
 Company Atlantic-Zenith, Magnolia
 Farm Name Blanche Sterling Unit No. 1

Co.

TOPS	DEPTH	LOG	DATUM	Loc. in Sec.
Anh.				C NW SW
Tr.				
H.	3829			
Tr.				
Dg.	3920	3918		
Bl.				
L.	4151	4196		Geol.
K.C.		4342		Contr.
B.K.C.				
Ce.		4734		Musgrove Tools
C.				
M.	49	4777	-4316	Pool
M.		4789	-4324	
K.				Hardtner
Mz.				
Mo.				
V.				
S.				
S.				
A.				
R.				
Pe.				
G.				
T.D.	4882			

COMPLETE

FEB 27 '57

E

No.

Sec.

T.

R.

Date Comm.

HURT NOV 21 '56 11-14-56 85/8

250/200 3080 NOV 21 '56

4685 DEC 5 '56 DST 4740-65

1hr G 1 1/2" ga 3,310 MCF/2"

rec 72' GCM FP 605-1045

BHP 1734/30" DST 4769-4820

1hr est 10 MCF G rec 64' 56CM

(550) FP 18-30 BHP 136/30

542 4882/200 DEC 12 '56 32/4748

-56 DEC 19 '55 Frac 10 X 10
 ga 3, 100 MCF + Ld 25/64"
 ch TP 840 CP 780#
 SITP 1575 SICP 1270
 ga 3, 810 MCFG + Ld 30/64" ch
 DEC 26 '55 JAN 2 '57 JAN 9 '57 JAN 16 '57

JAN 23 '57 JAN 30 '57 FEB 6 '57 FEB 13 '57 FEB 20 '57

SICP 1525 SITP 1505
 Flow 988 MCFG 18/64" ch
 TP 1270 CP 1360 + 1.67
 BFph 18% wt gran 17°
 FEB 27 '57 CSO est op Flow
 6,400 MCFG