


Section 33 Township 34 Range 34W

Well No. #1 Stephens

Company Plains Natural Gas

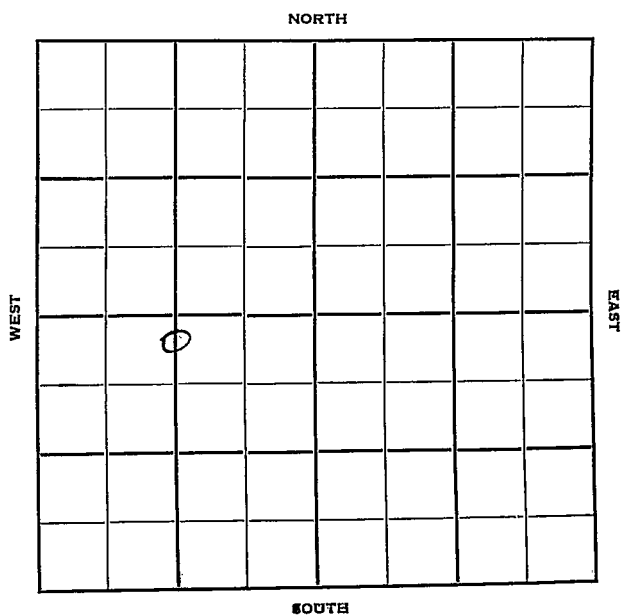

Seward

KANSAS

Sec. 33 Twp. 34 R. 34W

Well No. #1 Stephens Farm

Plains Natural Gas Company

Hugoton Pool Contractor

Ft. from N. Line

2440'


Ft. from S. Line

Ft. from E. Line

1320'

Ft. from W. Line

C N L SW/4

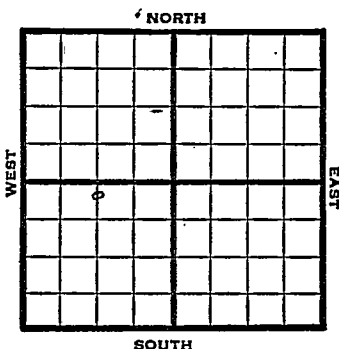

1950

Elev 2905' REPORT

9/27

Location

11/15

Spud 10-4-50

10" @ 658

Hol 2560

Her 2624

Krider 2655

TD 2708

7" @ 2708

132/2682-2704, 60/2656-66, 60/2632-42

30/2625-30

18000 A

Comp 7,630,000 gas

Completed

COMPLETED

County Seward State Kansas

Sec. **33** (Blk.) **34** (Sur.) **34W** Map No.

Operator **Plains Natural Gas**

Well No. 1 Farm Stephens

Elev. 2905 Location C N L SW/4

6

FIRST REPORT

2440 Ft. From S Line SW

1320 Ft. From ~~FF~~ Line Quarter

1st. Report SEP 27 1950

Completion.

Remarks

Spudding Date

Drlg. Data Hugoten Pool


Location

J. E. TYRA

Scout Cards
Land Small Map
Land Wall Map
Tracings
France Map
Pierce Map
Misc.

SEP 29 1958

Orig. Data

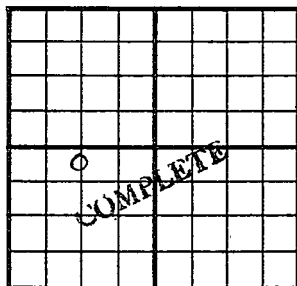County Seward State KansasSec. 33 (Blk. 34) (Sur. 34W) Map No. 34WOperator Plains Natural GasWell No. 1 Farm StephensElev. 2905 Location C N L SW/42440 Ft. From S Line SW1320 Ft. From W Line Quarter1st. Report Completion NOV 15 1951Remarks Hugoton PoolSpudding Date 10-4-50Drilg. Data Gas well TD 270810" @ 658 Hol. 2560 Her. 2624Krider 2655 TD 2708 7" @ 2707132/ 2682-2704 60/ 2656-66 60/ 2632-4230/ 2625-30 18000 A Comp. 7,630,000 gas

J. E. TYRA

NOV 21 1950

Scout Cards

76

Land Smo'l Map

Land Mail Map

Tracing

French Map

Pierre Map

Misc.

Orig. Data