


Section 33 Township 34 Range 39-W

Well Number 1 Walker

Company Kuhn Bros.

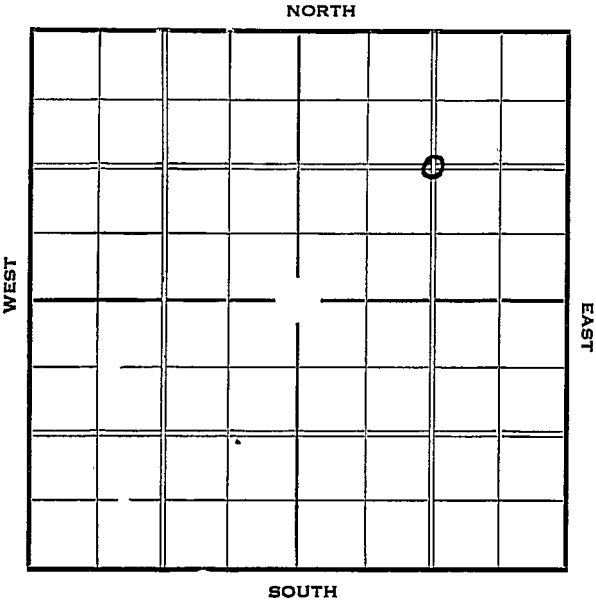

KANSAS

Morton

Sec. 33 Twp. 34 R. 39-W

Well No. #1 Walker Farm

Kuhn Bros. _____ Company


1320 Ft. from N. Line

Ft. from S. Line

1320 Ft. from E. Line

Ft. from W. Line

Elev. 3315

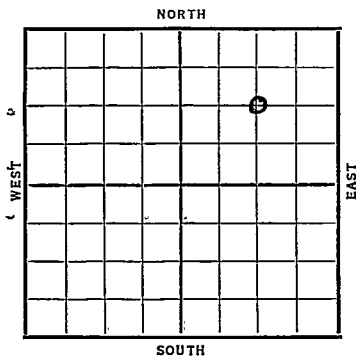

Date	REPORT
2/17	Rigging up.
2/28	" "
3/4	" "
3/11	" "
3/18	12" @ 623' WOC
3/25	Drlg. 2100'.
4/2	7" @ 2590' WOC
4/8	RUST
4/16	"
4/23	"
4/30	"
5/7	Est. 2 M gas 2645'.
	Drlg. 2650'.
5/14	" "
5/21	" "
	OVER

1937

5/26 7" @ 2590'.

Sand 2645'.

T.D. 2774'.

Shot 110 qts.

8,932,000 gas.

COMPLETED

Map No. No Map Sec. 33 Twp. 34 R. 39W

Well No. 1 Walker

Kuhn Bros. Company

Contractor

SECTION PLAT

1320 Ft. from N. Line

_____ Ft. from S. Line

1320 Ft. from E. Line

_____ Ft. from W. Line

FIRST REPORT

Location _____

Rig up _____

Drilling and Remarks:

Rigging up.

RECORD

Cased _____ in., _____ ft.

Sand _____

Gas _____

Oil _____

Total Depth _____

PRODUCTION

1st 24 hrs. Nat. _____

1st 24 hrs. after shot _____

Gas _____ Cu. Ft.

Dry Hole _____

Abandoned _____

Date

FEB 17 1937 19

S. J. LEWIS Scout

no wall
no small
RAY

Returned	_____
Cards	_____ <i>Paul</i>
Tracing	_____ <i>L</i>
France Map	_____ <i>L</i>
Scarborough Map	_____ <i>X</i>
Moody Map	_____ <i>L</i>
Scarborough Plat Book	_____
Moody Plat Book	_____


KANSAS

Morton

Map No. _____ Sec. 33 Twp. 34 R. 39 WWell No. 1-WalkerKuhn Bros Company_____
Contractor

(COMPLETED

SECTION PLAT

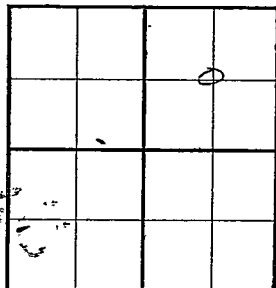1320 Ft. from N. Line :

____ Ft. from S. Line

1320 Ft. from E. Line :

____ Ft. from W. Line

Location _____

Rig up _____

Drilling and Remarks:

Shot 110 gts8, 932, 000 gal

RECORD

Cased 7 in., 2590 ft.Sand 2645

Gas _____

Oil _____

Total Depth 2774

PRODUCTION

1st 24 hrs. Nat. _____

1st 24 hrs. after shot _____

Gas _____ Cu. Ft.

Dry Hole _____

Abandoned _____

Date

MAY 26 1937 19 H. D. Hatfield Scout

My work

W

Returned	<i>Paul</i>
Cards	<i>Paul</i>
Tracing	<i>✓</i>
France Map	<i>✓</i>
Scarborough Map	<i>✓</i>
Moody Map	<i>✓</i>
Scarborough Plat Book	
Moody Plat Book	