

STATE CORPORATION COMMISSION OF KANSAS
OIL & GAS CONSERVATION DIVISION

WELL COMPLETION OR RECOMPLETION FORM
ACO-1 WELL HISTORY

DESCRIPTION OF WELL AND LEASE

Operator: License # 5469
Name Anadarko Production Company
Address Box 351
City/State/Zip Liberal, Kansas 67901

Purchaser J. M. Petroleum
Dallas, Texas

Operator Contact Person Paul Gatlin
Phone (316) 624-6253

Contractor: License # 7860
Name Johnson Drilling Company

Wellsite Geologist Charles Isbon
Phone (303) 893-8138

Designate Type of Completion
 New Well Re-Entry Workover

Oil SWD Temp Abd
 Gas Inj Delayed Comp.
 Dry Other (Core, Water Supply)

If OWNO: old well info as follows:
Operator
Well Name
Comp. Date Old Total Depth

WELL HISTORY

Drilling Method:
 Mud Rotary Air Rotary Cable
3/5/85 3/17/85 4/3/85
Spud Date Date Reached TD Completion Date
6691 6589
Total Depth PBTD

Amount of Surface Pipe Set and Cemented at 1655 feet
Multiple Stage Cementing Collar Used? Yes No
If yes, show depth set feet
If alternate 2 completion, cement circulated from feet depth to w/ SX cmt

API NO. 15-175-20,833
County Seward
E/2 NW SE 17 34S 34 East
Sec Twp Rge West

1980 Ft North from Southeast Corner of Section
1650 Ft West from Southeast Corner of Section
(Note: Locate well in section plat below)


Lease Name Goddard "C" Well # 2

Field Name Adamson

Producing Formation Lower Chester

Elevation: Ground 2971 KB 2982

Section Plat

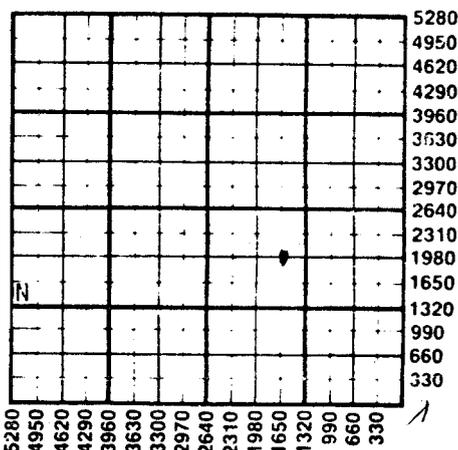

WATER SUPPLY INFORMATION

Disposition of Produced Water: Disposal
Docket # Repressuring

Questions on this portion of the ACO-1 call:
Water Resources Board (913) 296-3717

Source of Water:
Division of Water Resources Permit #

Groundwater Ft North from Southeast Corner
(Well) Ft West from Southeast Corner of
Sec Twp Rge East West

Surface Water Ft North from Southeast Corner
(Stream, pond etc) Ft West from Southeast Corner
Sec Twp Rge East West

Other (explain) Purchased from farmers well.
(purchased from city, R.W.D. #)

INSTRUCTIONS: This form shall be completed in duplicate and filed with the Kansas Corporation Commission, 200 Colorado Derby Building, Wichita, Kansas 67202, within 90 days after completion or recompletion of any well. Rule 82-3-130 and 82-3-107 apply. Information on side two of this form will be held confidential for a period of 12 months if requested in writing and submitted with the form. See rule 82-3-107 for confidentiality in excess of 12 months. One copy of all wireline logs and drillers time log shall be attached with this form. Submit CP-4 form with all plugged wells. Submit CP-111 form with all temporarily abandoned wells.

Operator Name Anadarko Production Company Lease Name Goddard "C" Well # 2

Sec. 17 Twp. 34S Rge. 34 East West County Seward

WELL LOG

INSTRUCTIONS: Show important tops and base of formations penetrated. Detail all cores. Report all drill stem tests giving interval tested, time tool open and closed, flowing and shut-in pressures, whether shut-in pressure reached static level, hydrostatic pressures, bottom hole temperature, fluid recovery, and flow rates if gas to surface during test. Attach extra sheet if more space is needed. Attach copy of log.

Drill Stem Tests Taken <input type="checkbox"/> Yes <input checked="" type="checkbox"/> No Samples Sent to Geological Survey <input checked="" type="checkbox"/> Yes <input type="checkbox"/> No Cores Taken <input type="checkbox"/> Yes <input checked="" type="checkbox"/> No	Formation Description <input type="checkbox"/> Log <input checked="" type="checkbox"/> Sample <table style="width:100%; border-collapse: collapse;"> <thead> <tr> <th style="text-align: left;">Name</th> <th style="text-align: left;">Top</th> <th style="text-align: left;">Bottom</th> </tr> </thead> <tbody> <tr> <td>Surface, Clay & Sand</td> <td>0'</td> <td>400'</td> </tr> <tr> <td>Redbed, Sand & Shale</td> <td>400'</td> <td>1645'</td> </tr> <tr> <td>Anhydrite</td> <td>1645'</td> <td>1659'</td> </tr> <tr> <td>Shale</td> <td>1659'</td> <td>2985'</td> </tr> <tr> <td>Lime & Shale</td> <td>2985'</td> <td>6691'</td> </tr> </tbody> </table>	Name	Top	Bottom	Surface, Clay & Sand	0'	400'	Redbed, Sand & Shale	400'	1645'	Anhydrite	1645'	1659'	Shale	1659'	2985'	Lime & Shale	2985'	6691'
Name	Top	Bottom																	
Surface, Clay & Sand	0'	400'																	
Redbed, Sand & Shale	400'	1645'																	
Anhydrite	1645'	1659'																	
Shale	1659'	2985'																	
Lime & Shale	2985'	6691'																	

Welex ran Dual Induction Guard Log and Compensated Density Dual Spaced Neutron Log.

	Oil	Gas	Water	Gas-Oil Ratio	Gravity
Estimated Production Per 24 Hours	200 Bbls	143 MCF	0 Bbls	688 CFPB	42.6 @ 60°

METHOD OF COMPLETION

Production Interval

Disposition of gas: Vented Open Hole Perforation
 Sold Other (Specify) 6394-6418
 Used on Lease Dually Completed
 To be sold

CASING RECORD New Used

Report all strings set-conductor, surface, intermediate, production, etc.

Purpose of String	Size Hole Drilled	Size Casing Set (in O.D.)	Weight Lbs/Ft.	Setting Depth	Type of Cement	#Sacks Used	Type and Percent Additives
Surface	12-1/4	8-5/8	24	1655	Pozmix	550	4% Gel
Production	7-7/8	4-1/2	11.6	6678	Class H Pozmix	200	3% CaCl
					Litewate	240	10% Salt
						75	

PERFORATION RECORD

Acid, Fracture, Shot, Cement Squeeze Record (Amount and Kind of Material Used) Depth

Shots Per Foot	Specify Footage of Each Interval Perforated	
2	6394-6418	
.....
.....
.....

TUBING RECORD Size 2-3/8 Set At 6392 Packer at _____ Liner Run Yes No

Date of First Production 4/3/85 Producing Method Flowing Pumping Gas Lift Other (explain).....

JOHNSON *Drilling Company, Inc.*



OFFICES IN
EVANSVILLE, INDIANA
TEL. (812) 428-4911
OKLAHOMA CITY, OKLAHOMA
TEL. (405) 943-7667

REPLY TO:

3535 N. W. 58th - Suite 710
Oklahoma City, Oklahoma 73112

March 22, 1985

Anadarko Production Company
P. O. Box 351
Liberal, Kansas 67901

Attn: Mr. Paul Gatlin

DRILLERS LOG for: Goodard "C" # 2
Section 17-34S-34W
Seward County, Kansas

0' - 400'	Surface, Clay, & Sand
400' - 1645'	Redbed, Sand, & Shale
1645' - 1659'	Anhydrite
1659' - 2985'	Shale
2985' - 6691'	Lime & Shale

JOHNSON DRILLING COMPANY, INC.

Signed by: *Claude D. Moore*

Claude D. Moore, Manager

STATE OF OKLAHOMA:

COUNTY OF OKLAHOMA:

Subscribed and sworn to before me this 22nd day of March, 1985.

Gloria P. Criser Notary Public

My Commission Expires: 10-17-87.