

STATE CORPORATION COMMISSION OF KANSAS
OIL & GAS CONSERVATION DIVISION

WELL COMPLETION OR RECOMPLETION FORM
ACO-1 WELL HISTORY

DESCRIPTION OF WELL AND LEASE

Operator: License # 5182
Name Southland Royalty Company
Address 2900 Liberty Tower
City/State/Zip Oklahoma City, OK 73102

Purchaser Koch Oil Company

Operator Contact Person Herb Schroeder
Phone 405/235-5515

Contractor: License # 5107
Name H-30, Inc.

Wellsite Geologist Jim Crawford
Phone 405/235-1147

Designate Type of Completion

☒ New Well ☐ Re-Entry ☐ Workover

☒ Oil ☐ SWD ☐ Temp Abd
☐ Gas ☐ Inj ☐ Delayed Comp.
☐ Dry ☐ Other (Core, Water Supply etc.)

If OMWO: old well info as follows:

Operator
Well Name
Comp. Date Old Total Depth

WELL HISTORY

Drilling Method:

☒ Mud Rotary ☐ Air Rotary ☐ Cable

7-15-85 7-27-85 7-29-85
Spud Date Date Reached TD Completion Date
6800' 6720'
Total Depth PBTD

Amount of Surface Pipe Set and Cemented at 1669 feet
Multiple Stage Cementing Collar Used? ☐ Yes ☒ No
If yes, show depth set feet
If alternate 2 completion, cement circulated
from feet depth to w/ SX cmt

API NO. 15-175-20-853

County Seward

C NE SE Sec. 19 Twp. 34 Rge. 34 ☐ East ☒ West


1980 Ft North from Southeast Corner of Section
660 Ft West from Southeast Corner of Section
(Note: Locate well in section plat below)

Lease Name Hampton Well # 2-19

Field Name R.G.

Producing Formation Chester

Elevation: Ground 2951 KB 2964
Section Plat

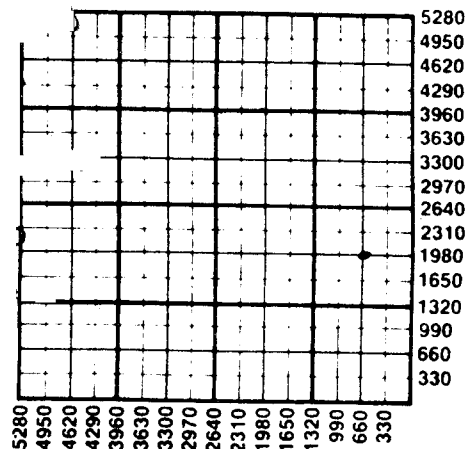

WATER SUPPLY INFORMATION

Disposition of Produced Water: ☐ Disposal
Docket # ☐ Repressuring

Questions on this portion of the ACO-1 call:
Water Resources Board (913) 296-3717

Source of Water:
Division of Water Resources Permit #

☒ Groundwater 300 Ft North from Southeast Corner
(Well) 600 Ft West from Southeast Corner of
Sec 19 Twp 34S Rge 34 ☐ East ☒ West

From Landowner Existing well
☐ Surface Water Ft North from Southeast Corner
(Stream, pond etc) Ft West from Southeast Corner
Sec Twp Rge ☐ East ☐ West

☐ Other (explain)
(purchased from city, R.W.D. #)

INSTRUCTIONS: This form shall be completed in duplicate and filed with the Kansas Corporation Commission, 200 Colorado Derby Building, Wichita, Kansas 67202, within 90 days after completion or recompletion of any well. Rule 82-3-130 and 82-3-107 apply.
Information on side two of this form will be held confidential for a period of 12 months if requested in writing and submitted with the form. See rule 82-3-107 for confidentiality in excess of 12 months.
One copy of all wireline logs and drillers time log shall be attached with this form. Submit CP-4 form with