

STATE CORPORATION COMMISSION OF KANSAS  
OIL & GAS CONSERVATION DIVISIONELL COMPLETION OR RECOMPLETION FORM  
ACO-1 WELL HISTORY

## DESCRIPTION OF WELL AND LEASE

Operator: license # 9229  
 name Douglas Energy Company, Inc.  
 address 6100 N. Robinson, Ste 202  
 City/State/Zip Okla., City, OK 73118

Operator Contact Person Jeff White  
 Phone 405-843-0400

Contractor: license # 5146  
 name Beredco

Wellsite Geologist Jeff White  
 Phone 405-843-0400

PURCHASER Santa Fe Minerals

## Date Type of Completion

☐ New Well ☐ Re-Entry ☒ Workover

☐ Oil ☐ SWD ☐ Temp Abd  
☒ Gas ☐ Inj ☐ Delayed Comp.  
☐ Dry ☐ Other (Core, Water Supply etc.)

NO: old well info as follows:

Operator  
 Well Name  
 Comp. Date Old Total Depth

## WELL HISTORY

Drilling Method: ☒ Mud Rotary ☐ Air Rotary ☐ Cable  
 initial: 12/7/84  
 10/11/84 10/21/84 workover: 7/22/85  
 Sp. Date Date Reached TD Completion Date

6684 6060  
 Total Depth PBTD

Ann of Surface Pipe Set and Cemented at 1686 feet  
 No-ken

Multiple Stage Cementing Collar Used? ☐ Yes ☒ No

If Yes, Show Depth Set feet

If alternate 2 completion, cement circulated  
 from feet depth to w/ SX cmt

API NO. 15-175-20,792

County Seward

150' W of C SE NW 19 Sec 19 Twp 34 Rge 34 X West  
 (location)


3300 Ft North from Southeast Corner of Section  
 3450 Ft West from Southeast Corner of Section  
 (Note: locate well in section plat below)

Lease Name James Well# 1

Field Name RG  
 Was: Lower Chester Is: Upper  
 Producing Formation Lower Morrow Morrow

Elevation: Ground 2954 KB 2967

Section Plat

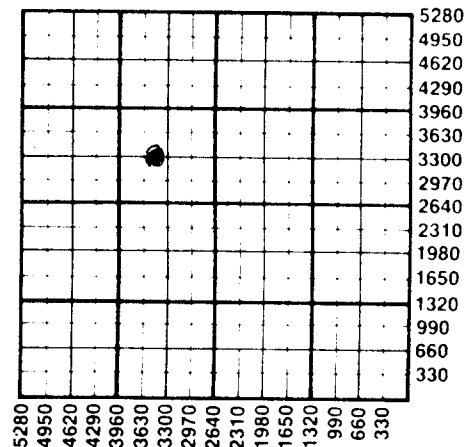

## WATER SUPPLY INFORMATION

Source of Water:

Division of Water Resources Permit # T-83-725

☒ Groundwater Ft North From Southeast Corner and  
 (Well) Ft West From Southeast Corner of  
 Sec Twp Rge East West

☐ Surface Water Ft North From Southeast Corner and  
 (Stream, Pond etc.) Ft West From Southeast Corner  
 Sec Twp Rge East West

☐ Other (explain)  
 (purchased from city, R.W.D.#)

Disposition of Produced Water: ☐ Disposal  
☐ Repressuring

Docket #

**INSTRUCTIONS:** This form shall be completed in duplicate and filed with the Kansas Corporation Commission, 200 Colorado Derby Building, Wichita, Kansas 67202, within 90 days after completion or recompletion of any well. Rules 82-3-130 and 82-3-107 apply.

Information on side two of this form will be held confidential for a period of 12 months if requested in writing and submitted with the form. See rule 82-3-107 for confidentiality in excess of 12 months.