

STATE CORPORATION COMMISSION OF KANSAS
OIL & GAS CONSERVATION DIVISION

WELL COMPLETION OR RECOMPLETION FORM
ACO-1 WELL HISTORY

DESCRIPTION OF WELL AND LEASE

Operator: license # .9229
name Douglas Energy Company, Inc.
address 4013 NW Expressway Suite 300
City/State/Zip Oklahoma City, OK 73116

Operator Contact Person Douglas L. Bendell
Phone (405) 843-0400

Contractor: license # .7860
name Johnson Drilling

Wellsite Geologist Edwin Grieves
Phone 405 721-2124

PURCHASER S

Designate Type of Completion
 New Well Re-Entry Workover

Oil SWD Temp Abd
 Gas Inj Delayed Comp.
 Dry Other (Core, Water Supply etc.)

WFO: old well info as follows:

Operator
Well Name
Comp. Date Old Total Depth

WELL HISTORY

Drilling Method: Mud Rotary Air Rotary Cable

4/13/84 4/26/84 5/21/84
Spud Date Date Reached TD Completion Date

6759 6578
Total Depth PBDT

Amount of Surface Pipe Set and Cemented at 1728 feet

Multiple Stage Cementing Collar Used? Yes No

If Yes, Show Depth Set feet

If alternate 2 completion, cement circulated from 6578 feet depth to 5838 w/ 150 SX cmt

wireline log received

API NO. 15 - 175-20,755

County Seward

150' S of C. SE SW Sec 19 Twp 34 Rge 34
(location)

510 Ft North from Southeast Corner of Secti
3300 Ft West from Southeast Corner of Secti
(Note: locate well in section plat below)


Lease Name Roy Green Well# 2-19

Field Name R.G.

Producing Formation Upper Chester Lm

Elevation: Ground 2,955 KB 2,967

Section Plat

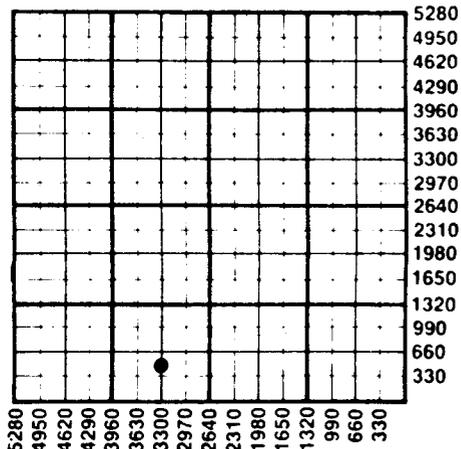

WATER SUPPLY INFORMATION

Source of Water:

Division of Water Resources Permit # T83-725

Groundwater 4290 330 Ft North From Southeast Corner a
(Well) Ft. West From Southeast Corner
Sec 19 Twp 34 Rge 34 East X West

Surface Water Ft North From Southeast Corner a
(Stream, Pond etc.) Ft West From Southeast Corn
Sec Twp Rge East West

Other (explain) (purchased from city, R.W.D.#)

Disposition of Produced Water: Disposal Repressuring

Docket #

INSTRUCTIONS: This form shall be completed in duplicate and filed with the Kansas Corporation Commission, 200 Colorado Derby Building, Wichita, Kansas 67202, within 90 days after completion or recompletion of any well. Rules 82-3-130 and 82-3-107 apply.

Information on side two of this form will be held confidential for a period of 12 months if requested in writing and submitted with the form. See rule 82-3-107 for confidentiality in excess of 12 months.

One copy of all wireline logs and drillers time log shall be attached with this form. Submit CP-4 form with all plugged wells. Submit CP-111 form with