

STATE CORPORATION COMMISSION OF KANSAS
OIL & GAS CONSERVATION DIVISIONWELL COMPLETION OR RECOMPLETION FORM
ACO-1 WELL HISTORY

DESCRIPTION OF WELL AND LEASE

Operator: License # 4549
 Name Anadarko Petroleum Corporation
 Address Box 351
 City/State/Zip Liberal, Kansas 67901

Purchaser NA

Operator Contact Person Paul Gatlin
 Phone (316) 624-6253

Contractor: License # 5842
 Name Gabbert-Jones, Inc.

Wellsite Geologist Greg Smith
 Phone (303) 223-1842

Designate Type of Completion

☒ New Well ☐ Re-Entry ☐ Workover

☐ Oil ☐ SWD ☐ Temp Abd
☐ Gas ☐ Inj ☐ Delayed Comp.
☒ Dry ☐ Other (Core, Water Supply etc.)

If OWWO: old well info as follows:

Operator
 Well Name
 Comp. Date Old Total Depth

WELL HISTORY

Drilling Method:

☒ Mud Rotary ☐ Air Rotary ☐ Cable

1/9/86 1/25/86 1/26/86
 Spud Date Date Reached TD Completion Date
 6725 Surface
 Total Depth PBTD

Amount of Surface Pipe Set and Cemented at 1627 feet
 Multiple Stage Cementing Collar Used? ☐ Yes ☒ No
 If yes, show depth set feet
 If alternate 2 completion, cement circulated
 from feet depth to w/ SX cmt

API NO. 15-175-20,896

County Seward

C. W/2 NE SW Sec. 26 Twp. 34S Rge. 34 ☐ East ☒ West

1980 Ft North from Southeast Corner of Section
 3630 Ft West from Southeast Corner of Section
 (Note: Locate well in section plat below)


Lease Name Mehl "A" Well # 1

Field Name Adamson

Producing Formation

Elevation: Ground 2891 KB 2904

Section Plat

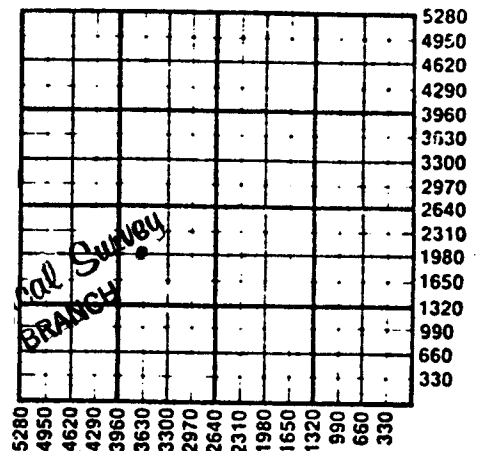

X WATER SUPPLY INFORMATION

Disposition of Produced Water: ☐ Disposal
 Docket # ☐ Repressuring

Questions on this portion of the ACO-1 call:

Water Resources Board (913) 296-3717

Source of Water:

Division of Water Resources Permit #

☐ Groundwater.....Ft North from Southeast Corner
 (Well)Ft West from Southeast Corner of
 Sec Twp Rge ☐ East ☐ West

☐ Surface Water.....Ft North from Southeast Corner
 (Stream, pond etc).....Ft West from Southeast Corner
 Sec Twp Rge ☐ East ☐ West

☒ Other (explain) Contractor furnished water
 (purchased from city, R.W.D. #)

INSTRUCTIONS: This form shall be completed in duplicate and filed with the Kansas Corporation Commission, 200 Colorado Derby Building, Wichita, Kansas 67202, within 90 days after completion or recompletion of any well. Rule 82-3-130 and 82-3-107 apply.
 Information on side two of this form will be held confidential for a period of 12 months if requested in writing and submitted with the form. See rule 82-3-107 for confidentiality in excess of 12 months.
 One copy of all wireline logs and drillers time log shall be attached with this form. Submit CP-4 form with all plugged wells. Submit CP-111 form with all temporarily abandoned wells.