
FORM 51 Sumner Kansas

Section 34 Township 34 Range 1W

Well No. #1 ~~Martin~~ McProud

Company ~~Herndon Drlg.~~

16

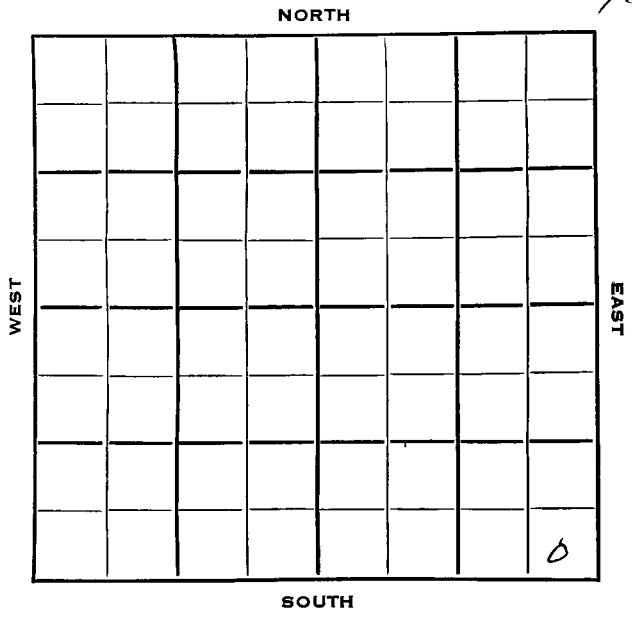

FORM 252-B
10M 8-51 TPCO.

KANSAS ✓

Sumner

Sec. 34 Twp. 34 R. 1W

Well No. #1 ~~Martin~~ McProod Farm

Herndon Drlg. Company

Herndon Drlg. Contractor


..... Ft. from N. Line

330 Ft. from S. Line

330 Ft. from E. Line

..... Ft. from W. Line

SE SE SE
Time Farmout

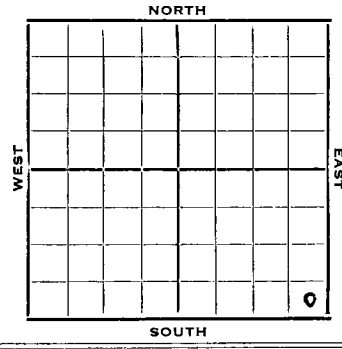

1953	Elev. 1113' REPORT
2/4	Location
2/12	"
2/19	RUR
2/26	8" @ 302 Drlg. 2270
3/11	Spud 2-17-53 D&A TD 4279 8" @ 302 Layton 3190, Miss 3913, Miss 3940, Kh. 4124, Woodfrod 4235, Misener 4259, Simp 4264 TD 4279 D&A

ABANDONED

Form 26 200 Bks. 8-50 Petrol

Kansas

Map No. _____ Sec. 34 Twp. 34 R. 1W


Well No. 1 McProud

Herndon Drlg. Company

CORRECTION Contractor

SE SE SE

SECTION PLAT

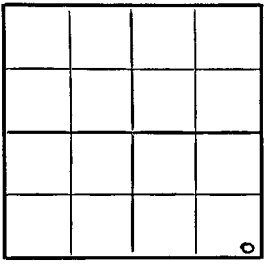

_____ Ft. from N. Line

330 Ft. from S. Line

330 Ft. from E. Line

_____ Ft. from W. Line

Sumner County

Location _____

Rig up _____

Drilling and Remarks:

Reported
#1 Martin

RECORD

Cased _____ in., _____ ft.

Sand _____

Gas _____

Oil _____

Total Depth _____

PRODUCTION

1st 24 hrs. Nat. _____

1st 24 hrs. after shot _____

Gas _____ Cu. Ft.

Dry Hole _____

Abandoned _____

Date

FEB 19 1953 19____

J. G. McGEHEE Scout

Form 26—200 Bks.—1-48—Palace

Kansas

Map No. _____ Sec. 34 Twp. 34 R. 1W


Well No. 1 McProud

Herndon Drlg. Company

CORRECTION Contractor

SE SE SE

SECTION PLAT

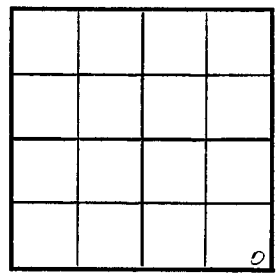

_____ Ft. from N. Line

330 Ft. from S. Line

330 Ft. from E. Line

_____ Ft. from W. Line

Sumner County

Location _____

Rig up _____

Drilling and Remarks:

Reported
#1 Martin

RECORD

Cased _____ in., _____ ft.

Sand _____

Gas _____

Oil _____

Total Depth _____

PRODUCTION

1st 24 hrs. Nat. _____

1st 24 hrs. after shot _____

Gas _____ Cu. Ft.

Dry Hole _____

Abandoned _____

Date

MAR 4 1953 19____

J. G. Mc[illegible] Scout

FORM 275 FOR SALE BY KANSAS BLUE PRINT CO.

County Sumner State Kansas

Sec. 34 (Blk. Twp.) 34 (Sur. Rge.) 1W Map No.

Operator Herndon Drlg.

Well No. 1 Farm Martin

Elev. Location SE SE SE

FIRST REPORT

330 Ft. From S Line SE

330 Ft. From E Line Quarter

1st. Report FEB 4 1953

Completion

Remarks Tire farmout

Herndon Drlg. - Contr.

Spudding Date

Drlg. Data

Location

J. G. McGEHEE

FORM 275 FOR SALE BY KANSAS BLUE PRINT CO


County Sumner State Kansas

Sec. 34 (Blk. Twp.) 34 (Sur. Rge.) 1W Map No.

Operator Herndon Drlg.

Well No. 1 Farm McProud

Elev. 1113 Location SE SE SE

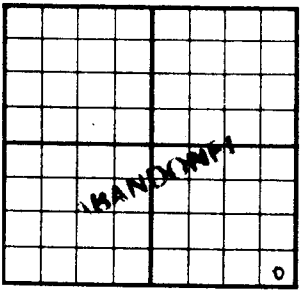

330 Ft. From S Line SE

330 Ft. From E Line Quarte

1st. Report

Completion MAR 1 [illegible] 1953

Remarks

Herndon Drlg. - Contr.

Spudding Date 2-17-53

Drlg. Data D & A TD 4279

8" @ 302 Layton 3190 Miss. 3913

Miss. 3940 Kh. 4124 Woodford 4235

Misener 4259 Simp. 4264 TD 4279

D & A

I. G. McGEHEE