


Section 34 Township 34 Range 25W

Well No. 1 Gross

Company Delhi Oil Corp.

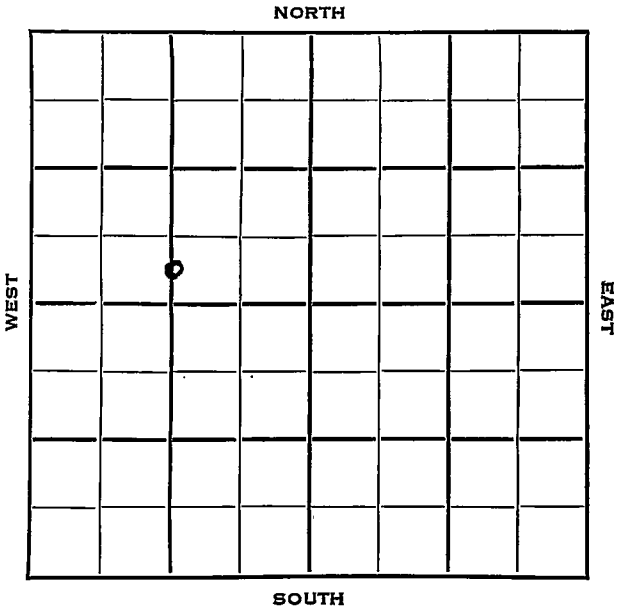

Clark

KANSAS

SEC.

TWP.

R.

34

34

25 W

WELL NO.

1 Gross

FARM

COMPANY

Delhi Oil Corp.

CONTRACTOR

Co. tools

Wildcat

2310

Ft. from N. Line

Ft. from S. Line


Ft. from E. Line

1350

Ft. from W. Line

SW SE NW

NORTH

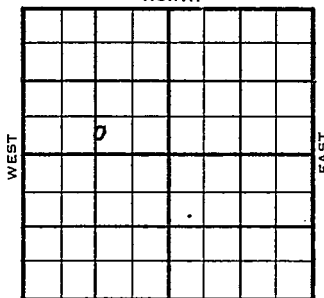

SOUTH

1954

ELEVATION

2013'

REPORT

Depp Test

5/5

RUR

5/12

20" @ 90'

13" @ 500'

9" @ 626'

Drlg. 2500'

5/19

Drlg 3700'

5/26

Heeb 4330', Lans 4520'

Drlg. 4850'

6/2

Marm 5232', Cher 5400'

Drlg. 5535'

6/9

Morrow 5696', Miss 5752'

RTD 5000' Schl

7/28

Spud 4-29-54 - Gas Well

TD 6000'

20" @ 90'

13" @ 500'

9" @ 621'

Heeb 4330', Lans 4520', Marm. 5232',

Cherokee 5400', Morrow 5696', Miss

5752'

TD 6000'

5" @ 5998'

CO to 5935'

70/5830-40, 500 M-A, VSSG, 2500A

F/6 mcfigpd

Comp. 7,350,000 cfcpd 11,000#

DX-78

COMPLETED

County Clark State Kansas
 Sec. 34 (Blk.) 34 (Sur.) 2 SW Map No.
 Operator Delhi Oil Corp.
 Well No. 1 Farm Gross
 Elev. _____ Location SW SE NW

FIRST REPORT

2310 Ft. From N Line NW
1350 Ft. From W Line Quarter
 Ist. Report MAY 5 1954
 Completion _____
 Remarks Deep test
Co. tools
 Spudding Date _____

Drlg. Data Wildcat
R U R

County Clark State Kansas
 Sec. 34 (Blk. 34 (Sur. 25W Map No.)
 (Twp.) (Rge.)
 Operator Delhi Oil Corp.
 Well No. 1 Farm Gross
 Elev. 2013 Location SW SE NW

COMPLETE

2310 Ft. From N Line NW
1350 Ft. From W Line Quarter
 Ist. Report
 Completion JUL 28 1954
 Remarks Wildcat
Co. tools
 Spudding Date 4-29-54

Drlg. Data Gas well TD 6000
20" @ 90 13" @ 500 9" @ 621
Heeb. 4330 Lans. 4520 Marm. 5232
Cherokee 5400 Morrow 5696 Miss. 5752
TD 6000 5" @ 5998 CO to 5935
70/ 5830-40 500 M-A VSSG 2500 A
F/ 6 mcfpd Comp. 7,350,000 cfcpd 1400#