

Seward KANSAS


DX 78-1

Section 31 Township 31 Range 33W

Well No. 1 Fincham Gas Unit "A"

Company Stanolind

NORTH

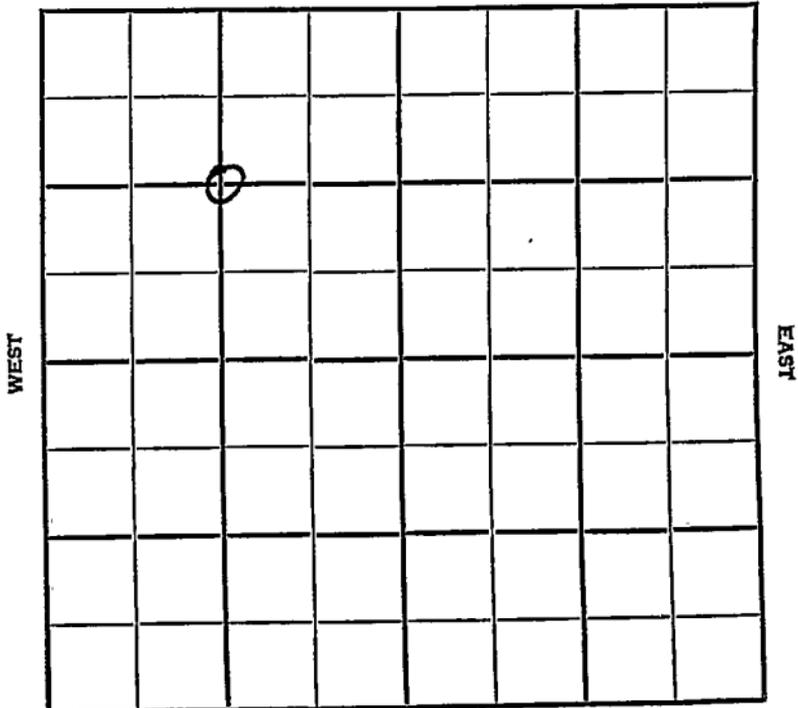

SOUTH

n Seward KANSAS

SEC.	34	TWP.	34	R.	33W
------	----	------	----	----	-----

WELL NO. 1 Fincham Gas Unit "A" FARM

COMPANY Stanolind

CONTRACTOR


Hugoton Pool

_____ Ft. from N. Line

1390 _____ Ft. from S. Line

1390 _____ Ft. from E. Line

_____ Ft. from W. Line

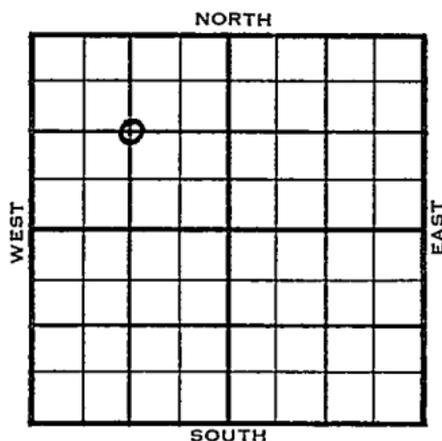

C NW/4

1954	ELEVATION 2823'	REPORT
------	--------------------	--------

7/21
8/25

Location
 Spud 7-21-54 Gas Well TD 2679
 8" @ 730 TD 2679 er. 2633
 K_{ri}. 2662 5" @ 2662 CO to 2679
 2500 A 72/2637-49 2000 A
 PB 2670 7000 A 901,000 CFG
 50 GAWPH Comp. open flow 2,466,000
 CFGPD 385#

COMPLETED

