


Section 34 Township 34 Range 43 W

Well No. # 1 Roll "B"

Company Cities Service

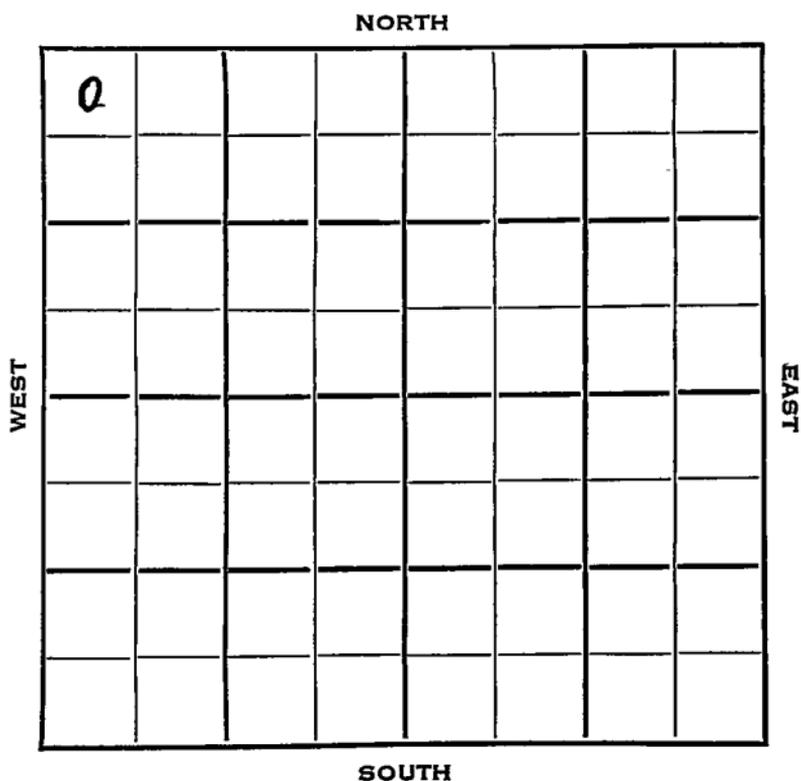



Sec. 34 Twp. 34 R. 13 W

Well No. # 1 Roll "B" Farm

Cities Service Company

Contractor

Greenwood Gas Pool


330 Ft. from N. Line

\_\_\_\_\_ Ft. from S. Line

\_\_\_\_\_ Ft. from E. Line

330 Ft. from W. Line

NW NW NW

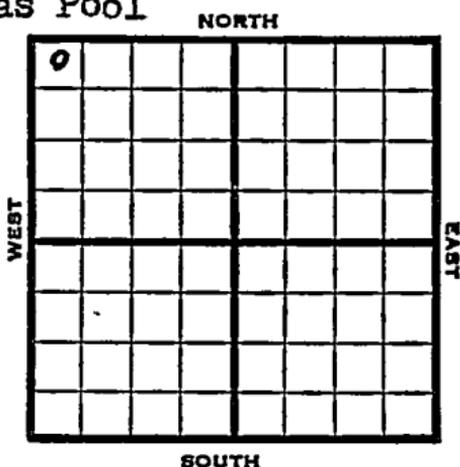

1953

Elev. 3515' REPORT

6/10

Location

6/24

8" @ 520  
RTD 3115  
Elec. Log  
5" @ 3114'

7/1

NR

7/15

Spud 6-10-53

D & A

TD 3115'

8" @ 520'

TD 3115'

5" @ 3114'

CO to 3043

70/ 3022-36 100/ 2990-

3010 3000 A

S/ 600 gsw 1 hr.

CO to 2985

50/ 2870-80

30/ 2860-66 1500 A

FU 750' fluid 12 hr. S/ 400 gswph

SP 2840

40/ 2778-86

60/ 2758-70

2000 A S/ 600 gswph Top. 2755,

Lans 2989

D & A

?  
3515  
2755

**ABANDONED**

3515  
2989  
+526

+760

County Morton State Kansas

Sec. 34 (Blk. 34 Twp.) (Sur. 43W Rge.) Map No.

Operator Cities Service

Well No. 1 Farm Roll #B

Elev. Location NW NW NW

0					

330 Ft. From N Line NW

330 Ft. From W Line Quarter

Ist. Report JUN 10 1953

Completion

Remarks

Spudding Date

Drlg. Data Greenwood Gas Pool

Location

County Morton State KansasSec. 34 (Blk.  
Twp.) 34 (Sur.  
Rgs.) 43W Map No.Operator Cities ServiceWell No. 1 Farm Roll "B"Elev. 3515 Location NW NW NW

0					

330 Ft. From N Line NW330 Ft. From W Line Quarter

1st. Report

Completion JUL 15 1953Remarks Greenwood GasSpudding Date - 6-10-53Drlg. Data D & A TD 31158" @ 520 TD 3115 5" @ 3114 CO to 304370/ 3022-36 100/ 2990-3010 3000 AS/ 600 gsw 1 hr. CO to 298550/ 2870-80 30/ 2860-66 1500 A FU 750'fluid 12 hr. S/ 400 gswph SP 284040/ 2778-86 60/ 2758-70 2000 AS/ 600 gswph Top. 2755 Lans. 2989D & A