

KANSAS


Stevens

Section 34 Township 34 Range 35W

Well No. 1 Parsley

Company Cities Service Gas

Hugoton Pool

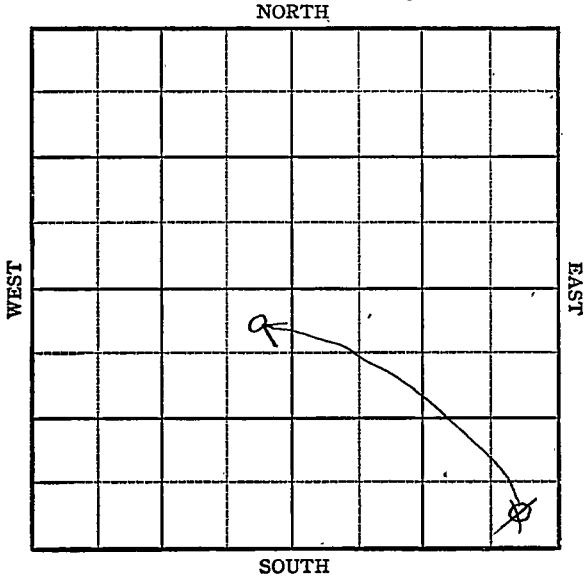

Sec. 34 Twp. 34 R. 35W

Well No. 1 Parsley Farm

Cities Service Gas Company

Hugoton Pool


120 Ft. from N. Line

Ft. from S. Line

190 Ft. from E. Line

Ft. from W. Line

NE SW

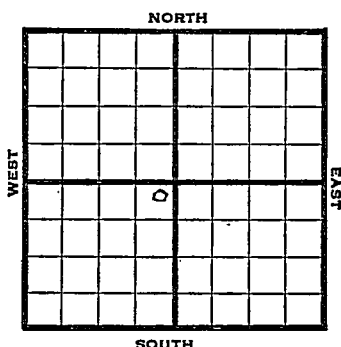

1948

Elev. 2979'

REPORT

8/25 825 run 10"

9/1 10" @ 721'
Drlg. 2560'

9/8 TD 2795'
7" @ 2673'
3000 acid

9/14 130' of 5" Perf liner
19,000 acid

9/22 7" @ 2673'
TD 2795'
130' of 5" Perf liner @ 2795'
Acid 19,000
Gas 22,141,000
R Pr. 421#

COMPLETED

Stevens County Kansas State

Map No. Sec. 34 Twp. 34 R. 35W

Well No. 1 Parsley

Cities Service Gas Company

COMPLETE

Contractor

NE SW

E 12978

SECTION PLAT

190 Ft. from N. Line

Ft. from S. Line

190 Ft. from E. Line

Ft. from W. Line

Hugoton Pool

Remarks:

9" @ 2673

7152785-

180' of 5" Perforated @ 2785

19000 acust

22,141,000 Gas

421 * RFE

Date

SEP 22 1948

Scout

S. J. LEWIS