

Morton


KANSAS

SECTION 34 TOWNSHIP 34 RANGE 42 W

WELL NO. #2-34 Land Bank

COMPANY Panhandle Eastern

NORTH

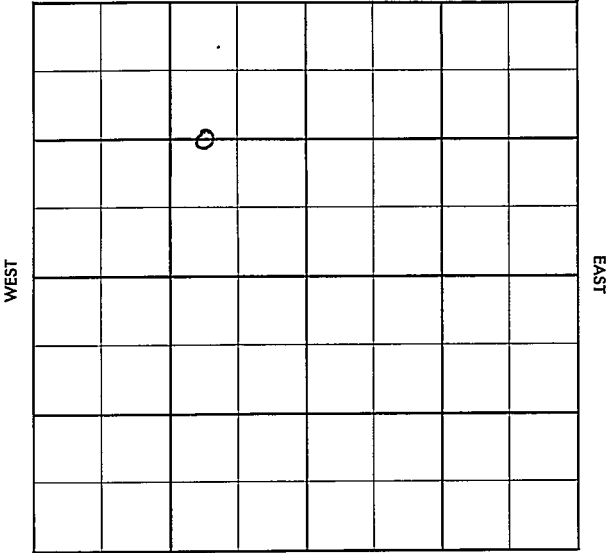

SOUTH

Morton

KANSAS

SEC.	TWP.	R.
24	34	42W

WELL NO. #2-34 Land Bank FARM

COMPANY Panhandle Eastern

CONTRACTOR Musgrove
Greenwood


1319 Ft. from N. Line

Ft. from S. Line

Ft. from E. Line

1519 Ft. from W. Line

W $\frac{1}{2}$ E $\frac{1}{2}$ NW

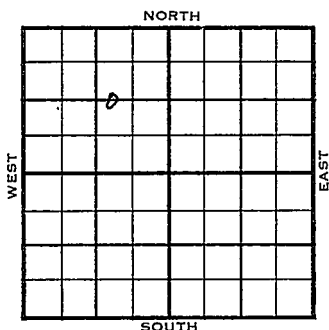

1955

ELEVATION

3538'

REPORT

10/26

Comm 10-21-55

8" @ 593/350

Drlg 1837

12-28

5 $\frac{1}{2}$ " @ 3698/375

CO 3675, 16/ 3656-60, 20/ 3647-52,
1000 A, SP 3615, 48/ 3552-64, 20/3529-
34, 24/ 3520-26, 1000 A, 1,846 mcfg
700 to 800 gwph, 24/ 3520-26, 20/3529-
34, 1000 A, 800 mcfg, 150 gswph, sq.
84/ 3448-62, 42/ 3426-33, 1000 A

73 mcfg,

PB 3415, 24/ 3380-84, 60/ 3365-75
24/ 3355-61, 48/ 3343-51, 200 mcfg,
8 hrs., 442 mcfg, 1000 A, 16, 450
mcfgpd, 1000 A, 17,675 mcfg 9 hrs.

PB 3125, 24/ 3091-97, 16/ 3075-79
24/ 2993-99, 56/ 2957-71, 32/ 2929-37
24/ 2903-09, 52/ 2874-87, 1,196 mcfg
3000 A, 17, 950 mcfg, 3000 A, 4 hrs.,
BD 18,895 mcfg 2000 A,

CO. to 3500

Comp. open flow 9 mcfgpd

Waub. 2631 - Log tops:

Top 2829

Greenwood 3066

L. 3256

TD 3700'

COMPLETED

NOV 2 1955

Scout Cards	<u>mm^c</u>
Land Small Map
Land Wall Map
Tracings
France Map
Pierce Map
Misc.

County Morton Elev. 3538
 Sec. 34 Twp. 34 Rge. 42W
 Company Pamhandle Eastern
 Farm Name Land Bank No. 2

TOPS	DEPTH	LOG	DATUM	Loc. in Sec.
Anh.				$W\frac{1}{2}$ $E\frac{1}{2}$ NW
Tr.				1319' NT.
Dg.				1519' WL
Bl. <u>Greenwood</u>		<u>3066</u>		
L.		<u>3256</u>		
K.C.				Geol.
B.K.C.				Contr.
Ce.				<u>Musgrove</u>
C.				
M.				Pool
M.				<u>Greenwood</u>
K.				
Mz.				
Mq.				
V.				
S.				
S.				
A.				
R.				
Pe.				
G.				
T.D.	<u>3700</u>			

Date Comm. 10-21-55 DEC 28 1955

8" @ .593/350 5 1/2" @ 3698/375
 CO 3675 16/ 3656-60 20/ 3647-52
 1000 A SP 3615 48/ 3552-64
 20/ 3529-34 24/ 3520-26 1000 A
 1,846 mcfg. 700 to 800 gwph 24/ 3520-26
 20/ 3529-34 1000-A 800 mcfg - 150 gswph
 sq. 84/ 3448-62 42/ 3426-33 1000 A
 73 mcfg PB 3415 24/ 3380-84 60/ 3365

JAN 6 1956

R. G.

75 24/ 3355-61 48/ 3343-51
200 mcfg 8 hr. 142 mcfg 1000 A
16,450 mcfgpd - 1000 A 17,675 mcfg 9 hr.
FB 3125 - 24/ 3091-97 16/ 3075-79
24/ 2993-99 56/ 2957-71 32/ 2929-37-
24/ 2903-09 52/ 2874-87 1,196 mcfg
3000 A 17,950 mcfg 3000 A
4 hr. BD 18,895 mcfg 2000 A GO to 3500
Comp. open flow/ 9 mmcfigpd