


Section 34 Township 34 Range 40-WWell No. #1 MagelsCompany Panhandle Eastern

NORTH

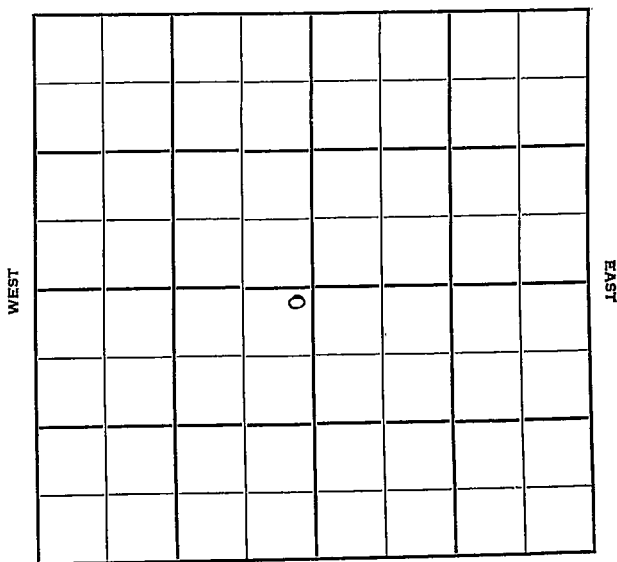

SOUTH

Morton

KANSAS

Sec. 34 Twp. 34 R. 40W ✓

Well No. #1 Magels Farm

Panhandle Eastern Company

Contractor

Hugoton Pool


3145' Ft. from N. Line

Ft. from S. Line

Ft. from E. Line

2440' Ft. from W. Line

NE SW

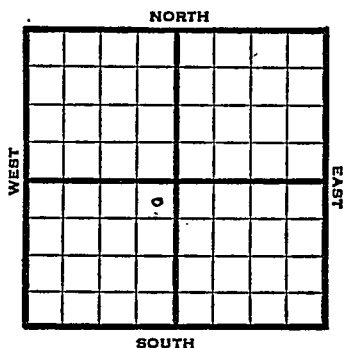

1950 Elev. 3378' REPORT

6/14 Location

10/4 Gas Well TD 2716'
10" @ 476' 7" @ 2507'
TD 2716'
Krider 2532' Win. 2618'
Ft. Riley 2670'
Comp. 22,929,000 gas

COMPLETED

Map No. _____ Sec. 34 Twp. 34 R. 40WWell No. 1 Magels

_____ Panhandle Eastern _____ Company

_____ Contractor


NE SW

SECTION PLAT

3145 Ft. from N. Line

_____ Ft. from S. Line

_____ Ft. from E. Line

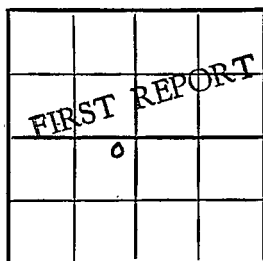2440 Ft. from W. Line

Morton County

Location X

Rig up _____

Drilling and Remarks:

RECORD

Cased _____ in., _____ ft.

Sand _____

Gas _____

Oil _____

Total Depth _____

PRODUCTION

1st 24 hrs. Nat. _____

1st 24 hrs. after shot _____

Gas _____ Cu. Ft.

Dry Hole _____

Abandoned _____

Date

JUN 14 1950 19J. E. TYRAS Scout



Sec. 34 (Blk. 34) (Sur. 40W) Map No. _____

Operator Panhandle Eastern

Well No. 1 Farm Mangels

Elev.	3378	Location	NE SW
-------	------	----------	-------

3145 Ft. From N Line SW

2440 Ft. From W Line Quarter

1st. Report

Completion OCT 4 1950

Remarks Hugoton Pool

Spudding Date _____

Drlg. Data Gas well TD 2716

10" @ 476 7" @ 2507 TD 2716

Krider 2532 Win. 2618 Ft. Riley 2670

Comp. 22,929,000 gas

J. E. TYRA