

# Harper


SEC. 35 TWP. 34 R. **KANSAS**  
7W

WELL NO. **1 Sallie Carr** FARM

COMPANY **C. H. Nicholson (Tulsa)**

CONTRACTOR **Irion Drlg**  
**Wildcat**

\_\_\_\_\_ Ft. from N. Line  
\_\_\_\_\_ Ft. from S. Line  
\_\_\_\_\_ Ft. from E. Line  
\_\_\_\_\_ Ft. from W. Line

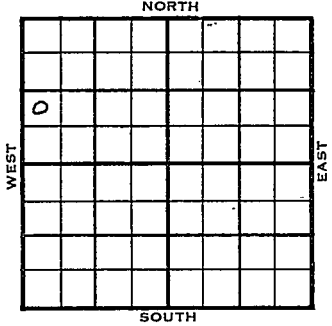

NW SW NW

	ELEVATION	REPORT
1955	1398	

5/26	Comm 5-4-55 H 3560; L 4110; M 4765; 8" @ 250 Oread 3515; Stal 3880; Drlg 4785
6/1	Comm 5-4-55 Anh 1580, Tp Oread 3515, H 3560, Dg Stal 3880, L 4110, BKC Marm 4440 Ce 4610, M 4765, Woodford 5225, V 5249, S Sd 5306 A 5512 TD 5562 8" @ 250 DST 5305-13 open 1 hr Rec 210' mud 4300' sw D&A

**ABANDONED**

Twp. 10 Pool. 10

Co. ✓ East K-27

# FIRST REPORT

FORM 513 REV. SUNRAY

County Harper Elev. 1398 Co. 1  
 Sec. 35 Twp. 34 Rge. 7W  
 Company C. H. Nicholson (Tulsa)  
 Farm Name Sallie Carr No. 1

TOPS	DEPTH	LOG	DATUM	Loc. in Sec.
Anh. <u>1580</u>				<u>NE SW NW</u>
Tr.				
H. <u>3560</u>				
Tr.				
Dg.				
Bl.				
L. <u>4110</u>				Geol. _____
K.C.				Contr. _____
B.K.C.				
Ce.				<u>Iron Drlg.</u>
C. <u>4765</u>				Pool _____
M.				<u>Wildcat</u>
M.				
K.				
Mz.				
Me.				
V.				
S.				
S.				
A.				
R.				
PE.				
G.				
ED.				

Date Comm. 5-4-55  
8" @ 250 Oread 3515 Stal. 3880  
drlg. 4785

K-27

Co. 1  
Lse. 1  
No. 1  
Sec. 1  
T. 1  
R. 1


County Harper Elev. 1398  
 Sec. 35 Twp. 34 Rge. 7W  
 Company C. H. Nicholson (Tulsa)  
 Farm Name Sallie Carr No. 1

TOPS	DEPTH	LOG	DATUM
Anh.	1580		182
Tp. <u>Oread</u>	3515		2117
H.	3560		2162
Tr.			
Dg. <u>stal.</u>	3880		2482
Bl.			
L.	4110		2712
K.C.			
B.K.C. <u>Marm</u>	4440		3042
Ce.	4610		3212
C.			
M.	4765		3367
M.			
* <u>Woodford</u>	5225		3827
Mz.			
Me.			
V.	5249		3951
S. <u>sd</u>	5306		3908
S.			
A	5512		4114
R.			
PE.			
G.			
T.D.	5562		

Loc. in Sec. NW SW NW

Geol. Iron Drlg.

Pool Wildcat

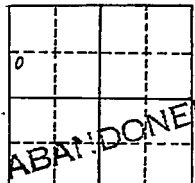

Date Comm. 5-4-55 JUN '1 1955

8" @ 250 DST 5305-13 open 1 hr.

Rec. 210' mud 4300' sw'

D & A

Co.  
Lse.  
No.  
Sec.  
T.  
R.