


Section 35 Township 34 Range 12 WWell No. #1 Samuel E. GoodCompany Sinclair O & G

NORTH

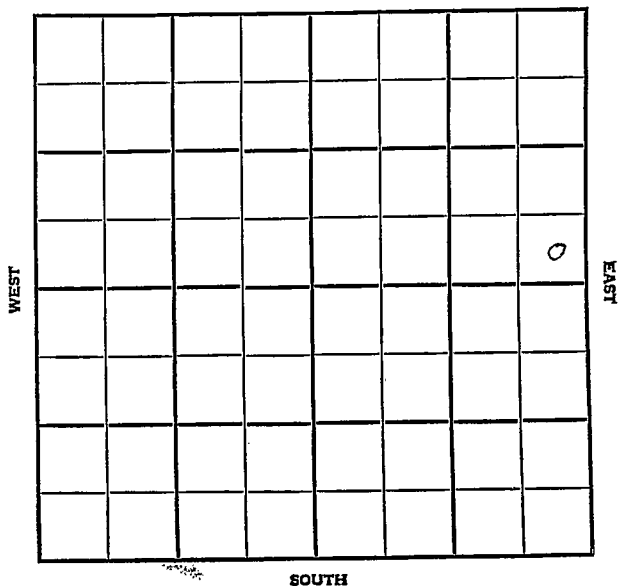

SOUTH

Barber

KANSAS

SEC.	TWP.	R.
35	34	12W

WELL NO.

#1 Samuel E. Good

FARM

COMPANY

Sinclair O&G

CONTRACTOR

7

WILDCAT


Ft. from N. Line

Ft. from S. Line

Ft. from E. Line

Ft. from W. Line

SE SE NE

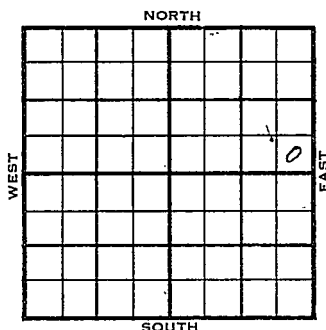

	ELEVATION	REPORT
1956	1439'	
2-1	Loc.	
3-21	Comm. 2-7-56 10 3/4" @ 268 DST 4107-16 op 1 hr. rec. 325' sw, 1565/16" DST 4750-61 op 1 hr. rec. 28' mud, 15/ DST 4556-92 op 3 hrs. 1010' gas, rec. 70' vso&gcm, 312/30" DST 4785-4820 op 4 hrs., 3360' GIP, 150' vso&gcm, 525/30" DST 5270-82 op 1 hr. rec. 20' mud, 90/30" DST 5478-5500 op 1 1/2 hr. rec. 910' sw, 2160/30" 5 1/2" @ 4889, CO to 4890, 264/4782-4848 S/ 35 bwph, 3 1/2 hrs. ### CO to 4890 Perf 4782-4815 B/ 15 gwph, 500 A S/ 4.72 bo 24 bw 24 hrs., 4000 A frac, lost load, D & A	

(OVER)

1956

3-21	Elg	3613	
	H.	3800	3806
	Dg. Sd	4106	
	L.	4342	4346
	Burgess	4749	
	Ce.		4754
	M.	4761-	4766
	K.	5020	5022
	Chata	5097	5098
	Mq.		5125
	V.	5177-	5175
	S. sh.	5269	5266
	S. Sd	5275	5270
	A.	5477-	5476
	TD	5500'	

ABANDONED

County Barber Elev. _____
 Sec. 35 Twp. 34 Rge. 12W
 Company Sinclair O & G
 Farm Name Samuel E. Good No. 1

TOPS	DEPTH	LOG	DATUM	Loc. in Sec.
Anh.				SE SE NE
TP.				
H.				
Tr.				
Dg.				
BL.				
L.				
K.C.				Geol. _____
B.K.C.				Contr. _____
Ce.				
C.				
M.				
M.				Pool
K.				Wildcat
Mz.				
Ma.				
V.				
S.				
S.				
A.				
R.				
Pe.				
G.				
ED.				

FIRST REPORT
 FEB 1 1955


Date Comm. _____
 Location _____

~~22~~

FEB 7 1956

R. G.

County Barber Elev. 1439
 Sec. 35 Twp. 34 Rge. 12W
 Company Sinclair O & G
 Farm Name Samuel E. Good No. 1

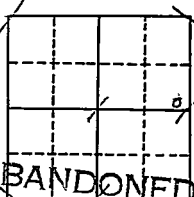TOPS	DEPTH	LOG	DATUM	Loc. in Sec.
Anh.				SE SE NE
TP. <u>E19</u>	<u>3613</u>			
H. <u>3800</u>	<u>3806</u>	<u>2367</u>		
Tr.				
Dg. <u>54</u>	<u>4106</u>		<u>2667</u>	
Bl.				
L. <u>4342</u>	<u>4346</u>	<u>2907</u>		Geol.
K.C. <u>Burgess</u>	<u>4749</u>	<u>3310</u>		
B.K.C.				Contr.
Ce.		<u>4754</u>	<u>3315</u>	
C.				
M. <u>4761</u>	<u>4766</u>	<u>3327</u>		Pool
M.				
K. <u>5020</u>	<u>5022</u>	<u>3583</u>		Wildcat
Mz. <u>Chatra</u>	<u>5097</u>	<u>5098</u>	<u>3657</u>	
Ma.		<u>5125</u>	<u>3686</u>	
V. <u>5177</u>	<u>5175</u>	<u>3736</u>		
S. <u>51</u>	<u>5269</u>	<u>5266</u>	<u>3828</u>	
S. <u>54</u>	<u>5275</u>	<u>5270</u>	<u>3831</u>	
A. <u>5477</u>	<u>5476</u>	<u>4037</u>		
R.				
Pe.				
G.				
TD. <u>5500</u>				ABANDONED

Date Comm. 2-7-56 MAR 21 1956

10 3/4" @ 268 DST 4107-16 open 1 hr.

rec. 325' sw 1565/16" DST 4750-61

open 1 hr. rec. 28' mud 15/

DST 4556-92 open 3 hr. 1010' gas

rec. 70' vso & gcm 312/30" DST 4785-

4820 open 4 hr. 3360' GIP

150' vso-& gcm 525/30" DST 5270-82

open 1 hr. rec. 20' mud 90/30"

OVER

DST 5478-5500 open $1\frac{2}{3}$ hr. rec. 910' SW
2160/30" . 5 $\frac{3}{4}$ " @ 4889 CO to 4890
264/4782-4848 S/35 bwph 3 $\frac{2}{3}$ hr.
CO to 4890 perf. 4782-4815 B/15 gwph
500 A S/4.72 to 24 bw 24 hr. 4000 A
Trac Most Load :

D & A

R. G.

APR 2 1956