

Barber

KANSAS

35

34

13W


SECTION _____ TOWNSHIP _____ RANGE _____

WELL NO. #1 Edd Sterling

COMPANY Amerada Petro. Corp.

NORTH

C NW NW

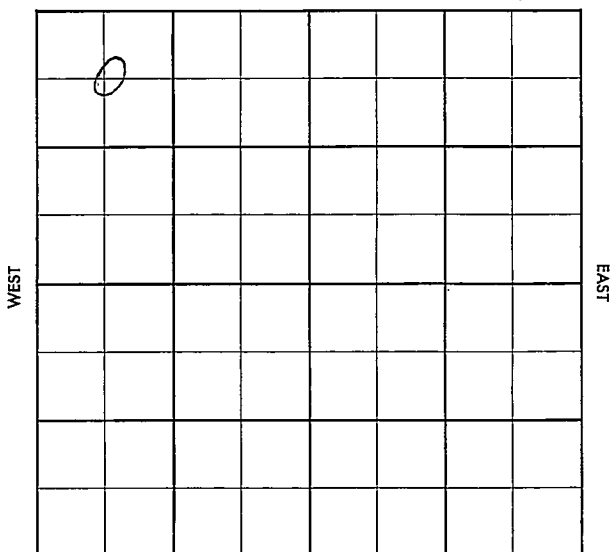

SOUTH

County Barber Elev. _____
 Sec. 35 Twp. 34 Rge. 13W
 Company Amerada Petroleum Corp.
 Farm Name Edd Sterling No. 1

TOPS	DEPTH	LOG	DATUM	Loc. in Sec.																
Anh.				C NW NW																
Tp.																				
H.																				
Tr.																				
Dg.																				
Bl.																				
L.				Geol. _____																
K.C.				Contr. _____																
B.K.C.																				
Ce.																				
C.																				
M.																				
M.				Pool																
K.				<u>Elwood</u>																
Mz.				<table border="1"> <tr> <td>0</td> <td></td> <td></td> <td></td> </tr> <tr> <td colspan="4" style="text-align: center;">AUG 14 '57</td> </tr> <tr> <td colspan="4" style="text-align: center;">FIRST REPORT</td> </tr> <tr> <td></td> <td></td> <td></td> <td></td> </tr> </table>	0				AUG 14 '57				FIRST REPORT							
0																				
AUG 14 '57																				
FIRST REPORT																				
Me.																				
V.																				
S.																				
S.																				
A																				
R.																				
PE.																				
G.																				
T.D.																				

Date Comm. _____

Location _____

~~26~~

Co. Lse. F. No. Sec. T. R.

County Barber Elev. 1479
 Sec. 35 Twp. 34 Rge. 13W
 Company Amerada Petroleum Corp.
 FarmName Edd Sterling No. 1

TOPS	DEPTH	LOG	DATUM	Loc. in Sec.									
Anb. <u>E1920</u>		<u>3588</u>		C NW NW									
Tr. <u>" 30</u>		<u>3587</u>											
H.													
Tr.													
Dg.													
Bl.													
L.				Geol.									
K.C.													
B.K.C.				Contr.									
Ce.													
C.													
M.													
M.				Pool									
K.				<u>Elwood</u>									
Mz.													
Mq.													
V.													
S.													
S.													
A.													
R.													
PE.													
G.													
TD.	<u>3609</u>			<table border="1"> <tr> <td>0</td> <td></td> <td></td> </tr> <tr> <td colspan="3" style="text-align: center;">COMPLETE</td> </tr> <tr> <td></td> <td></td> <td>SEP 11 '57</td> </tr> </table>	0			COMPLETE					SEP 11 '57
0													
COMPLETE													
		SEP 11 '57											

Date Comm. Aug 29 57
 Location 8-21-57
8 5/8 @ 298/225 @ 3240
SEP 4 '57 DST 3590-3609 1hr 6 1/2"
9a 2,190 MCF/5" 9a 4,150
MCF/45" FP 180-545 BHP
1400/20" 5 1/2 3608/150 SEP 11 '57
20/35 96-3601 250 acid 9a
340 MCF 17 1/2 hrs 2" I Frac
10 x 10 5,295 MCF CP 1120

TP 940 ga 5.800 MCFpd
1" ck TP 850