

FORM 51 25M 3-49 PETROL

Section 35 Township 34 Range 35WWell No. #1 RennickCompany Cities Service

NORTH

			0				

WEST

EAST

SOUTH

Stevens **KANSAS** ✓

Sec. 35 Twp. 34 R. 35W

Well No. #1 Rennick Farm

Cities Service

Company

Hugoton Pool (Gorbett & Barber, ~~non~~ Contr.)


100' Ft. from N. Line

 Ft. from S. Line

100' Ft. from E. Line

 Ft. from W. Line

NE SW

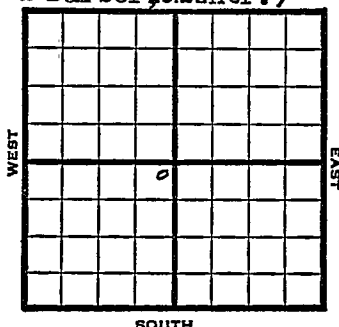

1949	Elev 2966'	REPORT
12/28	Location	
1950		
2/8	8" @ 800' TD 2830'	
	5" set 2829'	
	Her 2654'	
	Up Cr 2678'	
	L Cr 2706'	
	Win 2762'	
	21,800,000 CFGPD	
	Comp	
	COMPLETED	

Map No. _____ Sec. 35 Twp. 34 R. 35W

Well No. 1 Rennick

_____ Cities Service _____ Company

_____ Corbett & Barber _____ Contractor

NE SW


**FIRST REPORT
SECTION PLAT**

100 Ft. from N. Line

_____ Ft. from S. Line

100 Ft. from E. Line

_____ Ft. from W. Line

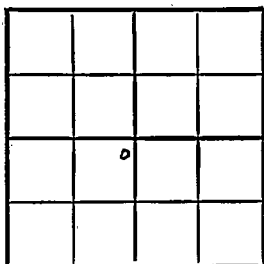

Stevens County

Location X

Rig up _____

Drilling and Remarks:

RECORD

Cased _____ in., _____ ft.

Sand _____

Gas _____

Oil _____

Total Depth _____

PRODUCTION

1st 24 hrs. Nat. _____

1st 24 hrs. after shot _____

Gas _____ Cu. Ft.

Dry Hole _____

Abandoned _____

Date

DEC 28 1949 19

S. J. LEWIS Scout

Map No. _____ Sec. 35 Twp. 34 R. 35^W

Well No. 1 Rennick

Cities Service

Company

Contractor

NE SW

E. 2966
SECTION FLAT

100 Ft. from N. Line

Ft. from S. Line

100 Ft. from E. Line

Ft. from W. Line

COMPLETE			

Stevens County

Location

Rig up

Drilling and Remarks:

8' @ 800
5' @ 2829
Hcr 2654
up Cr 2678
L Cr. 2706
Win 2762

RECORD

Cased _____ in., _____ ft.

Sand _____

Gas _____

Oil _____

Total Depth 2830

PRODUCTION

1st 24 hrs. Nat. _____

1st 24 hrs. after shot _____

Gas _____ Cu. Ft.

Dry Hole _____

Abandoned _____

21,800,000 C F G P D

Date

FEB 8 1950

19

J. E. TYRA

Scout