


Section 35 Township 31 Range 11WWell No. #1 Engleman "A"Company Cities Service

NORTH

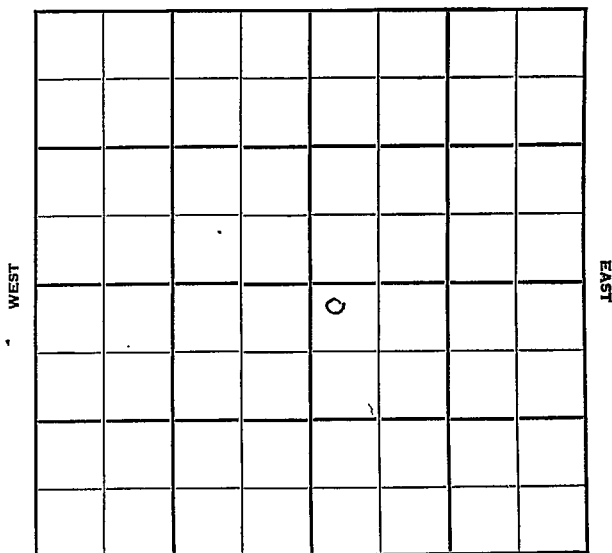

SOUTH

Morton

KANSAS

Sec. 35 Twp. 34 R. 41W

Well No. #1 Engleman "A" Farm

Cities Service

Company

Contractor


225' Ft. from N. Line

_____ Ft. from S. Line

_____ Ft. from E. Line

225' Ft. from W. Line

NW SE

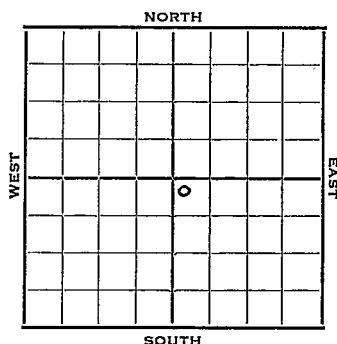

1952 Elev. 3420' REPORT

2/17 8" @ 360
WOC
Spud 2-17-52

2/20 "

3/5 CO to 2449 30/2442-48 NS
2000 A 620,000 gas 60/2416-28
120/2362-86 40/2342-50

3/12 DO to 2449 30/2442-48 2000 A
60/2416-28 120/2367-86
40/2342-50 14,500 A

3/19 Spud 2-17-52
Gas well TD 2465' 8" @ 360
5" @ 2463 TD 2465' Her. 2290'
Kri. 2347' Win. 2408' CO to 2449'
30/2442-48 2000 A 620,000 gas
60/2416-28 120/2362-86 40/2342-50
DP to 2449 30/2442-48 60/2416-28
120/2362-86 40/2342-50 14,500 A
Comp. 1,460,000 gas

COMPLETED

County Worton State Kansas

Sec. 35 (Blk.) 34 (Sur.) 41W Map No. (Twp.) (Rge.)

Operator **Cities Service**

Well No. **1** Farm **Engleman "A"**

Elev.	Location	NW	SE
-------	----------	----	----

225 Ft. From N Line SE

225 Ft. From W Line Quarter

1st. Report FEB 20 1952

Completion

Remarks


Spudding Date 2-17-52

Drlq. Data

8" @ 360 WCC

J. G. McGEHEE

County Morton State Kansas
 Sec. 35 (Blk. 34 (Sur. 41W Map No.
 (Twp.) (Rge.)
 Operator Cities Service
 Well No. 1 Farm Engleman "A"
 Elev. 3420 Location NW SE

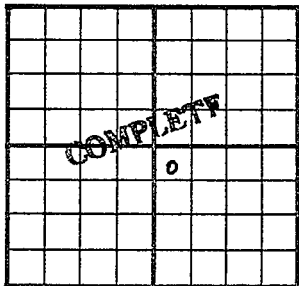

225 Ft. From N Line SE
225 Ft. From W Line Quarter
 Ist. Report
 Completion MAR 19 1952
 Remarks

Spudding Date 2-17-52
 Drlg. Data Gas well TD 2465

8" @ 360 5" @ 2463 TD 2465

Her. 2290 Kri. 2347 Win. 2408

CO to 2449 30/ 2442-48 2000 A

620,000 gas 60/ 2416-28 120/ 2362-86

40/ 2342-50 DP to 2449 30/ 2442-48

60/ 2416-28 120/ 2362-86 40/ 2342-50

14500 A Comp. 1,460,000 gas

J. G. McGEHEE