

DX 78-1

Morton

KANSAS

35

34


42W

Section _____ Township _____ Range _____

Well No. #1 Westerfield

Company P E P L

NORTH

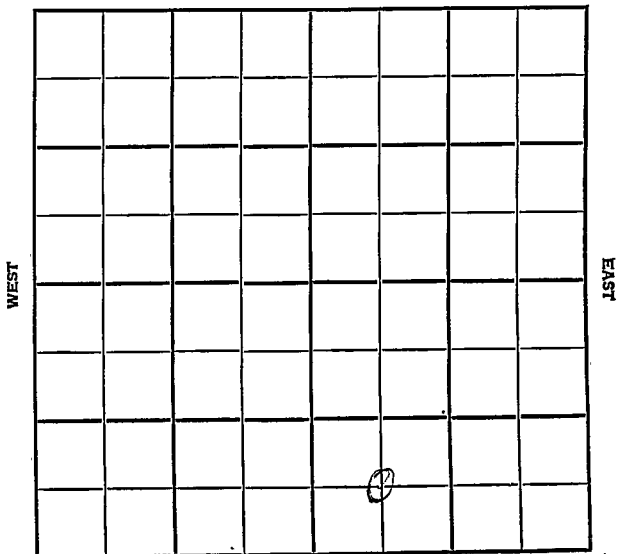

SOUTH

County Morton Elev. 3518
 Sec. 35 Twp. 34 Rge. 42W
 Company P F P L
 Farm Name Westerfield No. 0-1

TOPS	DEPTH	LOG	DATUM	Loc. in Sec.
Anb.				C SW SE
Tp. <u>W26</u>		<u>2687</u>		
H. <u>TP</u>		<u>2886</u>		
Tr.				
Dg.				
Bl.				
L. <u>CSO</u>		<u>3143</u>		Geol.
K. <u>LS9</u>		<u>3329</u>		
BXC.				Contr.
Ce. <u>Martin</u>		<u>3878</u>		Nye & Snell
C. <u>ce</u>		<u>3957</u>		Tools
M. <u>MW</u>		<u>4166</u>		Pool
M. <u>" sd</u>		<u>4176</u>		Talagoa
K. <u>" sd</u>		<u>4219</u>		
Mz. <u>" sd</u>		<u>4552</u>		
Mq. <u>Keyes</u>		<u>4594</u>		
V. <u>M155</u>		<u>4602</u>		
S.				
Sv.				
A.				
R.				
PE.				
G.				
TR. <u>4660</u>	<u>4700</u>			

COMPLETE
 DEC 5 '56
 * 0

Date Comm. spd. 10-9-56

8" @ 1505 w/800, Drlg. 2664

10-24-56 W 4640 OCT 31 '56 DST 4539

-66 on this sec 120' 01' E' GCM

+180' M E GCO FPO-80 BHP

900/20 5 1/2 @ 4616/400 CO 4660

48/4553-65 W 15 G. FRAE

\$ 7 1/2 BO. No time NOV 7 '56 NOV 13 '56

NOV 21 '56 NOV 28 '56 DEC 5 '56 P 111

Bopd. No. 125