

19-34-36W

State Geological Survey
WICHITA, BRANCH

KANSAS DRILLERS LOG

S. 19 T. 34 R. 36 NW

API No. 15 - Stevens¹⁸⁹⁻ 20, 171
County Number

Loc. C NW

County Stevens

Operator
Campbell & Marden

Address
P.O. Box 1313, Liberal, Kansas 67901


Well No. #1-19 Lease Name Peachy

Footage Location
1250 feet from (N) line 1250 feet from (W) line

Principal Contractor Sage Drilling Company Geologist D. W. Marden

Spud Date 3-8-73 Total Depth 6875 (Drtr) P.B.T.D. None

Date Completed 3-26-73 Oil Purchaser None

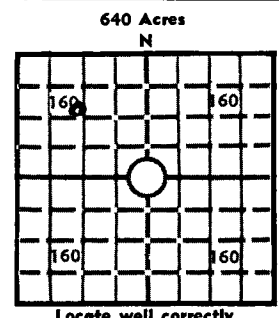

Elev.: Gr. 3114

DF 3121 KB 3123

CASING RECORD

Report of oil strings set — surface, intermediate, production, etc.

Purpose of string	Size hole drilled	Size casing set (in O.D.)	Weight lbs/ft.	Setting depth	Type cement	Sacks	Type and percent additives
<u>Protect water zones</u>	<u>10 3/4</u>	<u>8 5/8</u>	<u>23#</u>	<u>1767'</u>	<u>Half 14 wt. Common</u>	<u>550</u> <u>150</u>	<u>2% CaCl</u> <u>3% CaCl</u>

LINER RECORD

PERFORATION RECORD

Top, ft.	Bottom, ft.	Sacks cement	Shots per ft.	Size & type	Depth interval

TUBING RECORD

Size	Setting depth	Packer set at

ACID, FRACTURE, SHOT, CEMENT SQUEEZE RECORD

Amount and kind of material used	Depth interval treated
<u>None</u>	

INITIAL PRODUCTION

Date of first production		Producing method (flowing, pumping, gas lift, etc.)			
RATE OF PRODUCTION PER 24 HOURS	Oil	Gas	Water	Gas-oil ratio	
Disposition of gas (vented, used on lease or sold)			Producing interval (s)		

INSTRUCTIONS: As provided in KCC Rule 82-2-125, within 90 days after completion of a well, one completed copy of this Drillers Log shall be transmitted to the State Geological Survey of Kansas, 4150 Monroe Street, Wichita, Kansas 67209. Copies of this form are available from the Conservation Division, State Corporation Commission, 3830 So. Meridian (P.O. Box 17027), Wichita, Kansas 66217. Phone AC 316-522-2206. If confidential custody is desired, please note Rule 82-2-125. Drillers Logs will be on open file in the Oil and Gas Division, State Geological Survey of Kansas, Lawrence, Kansas 66044.

Operator

DESIGNATE TYPE OF COMP.: OIL, GAS, DRY HOLE, SWDW, ETC.:

Well No.

Lease Name

S _____ T _____ R _____ E _____
W _____


WELL LOG

Show all important zones of porosity and contents thereof; cored intervals, and all drill-stem tests, including depth interval tested, cushion used, time tool open, flowing and shut-in pressures, and recoveries.

SHOW GEOLOGICAL MARKERS, LOGS RUN, OR OTHER DESCRIPTIVE INFORMATION.

FORMATION DESCRIPTION, CONTENTS, ETC.	TOP	BOTTOM	NAME	DEPTH

USE ADDITIONAL SHEETS, IF NECESSARY, TO COMPLETE WELL RECORD.

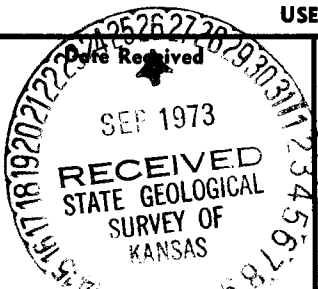

Signature

Title

Date