

Barber KANSAS

Well No. # 1 Kastens

Company Purcell-Mull Drlg.

0

WEST

EAST

T-100

SOUTH

SEC.	TWP.	R.
36	34	11W

WELL NO.

#1 Kastens

FARM

COMPANY

Purcell-Mull Drlg.

CONTRACTOR

Co. Tools.

Wildcat.

330


Ft. from N. Line

Ft. from S. Line

Ft. from E. Line

330

Ft. from W. Line

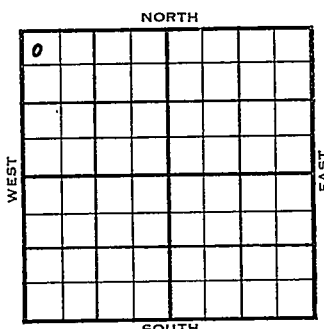

NW NW NW
Continental - DHM

	ELEVATION	REPORT
1955	1313'	
1/12	Spud 1-11-55	
2/23	Spud 1-11-55 D & A TD 5345	
	8" @ 193 Elgin 3456	
	DST 3490-3500 open 1½ hr rec 3919	
	130' MSW, 1220# Stal. 3914	
	DST 3919-31 open 1 hr rec 450' gas,	
	50' GCM, 135' muddy SGCW 1460#	
	IC 4182 Miss 4656'	
	DST 4657-70 open 1½ hr rec 900' gas,	
	50' GCM, 460#	
	DST 4670-85 open 1½ hr, rec 630' gas,	
	95' SHOCM, 910#.	
	DST 4254-81 open 1 hr rec 330' S GCM	
	1960#. DST 4686-4710 open 2 hr rec	
	278' fluid, 38' SOCM 1380#.	
	DST 4711-25 open 1½ hr rec 150' gas,	
	40' gassy OCM, 100' SOCMW, 60' WTr.	
	mud, 1300# Viola 5026' Simp. sh 5109	
	Simp. sd 5119' DST 5274-82 open 3/4	
	hr, rec 35' mud Off. Arb. 5322	
	TD 5345' 5" @ 4780 CO to 4750	
	Perf/4742-46 750 M-A S/9 BWPH	
	D & A	
	ABANDONED	

County Barber State Kansas
 Sec. 36 (^{Blk.}Twp.) 34 (^{Sur.}Rge.) 11W Map No. _____
 Operator Purcell-Mull Drlg.
 Well No. 1 Farm Kastens
 Elev. 1313 Location NW NW NW

0					

330 Ft. From N Line NW
330 Ft. From W Line Quarter

1st. Report

Completion FEB 23 1955

Remarks Wildcat

Co. tools

Spudding Date 1-11-55

Drlg. Data D & A TD 5345
8" @ 193 Elgin 3456 DST 3490-3500
open $1\frac{1}{2}$ hr. Rec. 130' msw 1220#
Stal. 3914 DST 3919-31 open 1 hr.
Rec. 450' gas 50' gcm 135' muddy ggcw
1460# KC 4182 Miss. 4656 DST 4657-70
open $1\frac{1}{2}$ hr. Rec. 900' gas 50' gcm
460# DST 4670-85 open $1\frac{1}{2}$ hr.
Rec. 630' gas 95' shocm 910#
DST 4254-81 open 1 hr. Rec. 330' sgcm
1960# DST 4686-4710 open 2 hr.
Rec. 278' fluid 38' socm 1380#
DST 4711-25 open $1\frac{1}{2}$ hr. Rec. 150' gas
40' gassy ocm 100' socmw 60' wtr. mud
1300" Viola 5026 Simp. sh. 5109

OVER

FABEN GILSTRAP

Drilg. Data

Simp. sd. 5119 DST 5274-82 open 3/4 hr

Rec. 35' mud 0# Arb. 5322 TD 5345

5" @ 4780 CO to 4750 perf/ 4742-46

750 M-A S/ 9 bwrph



WAR 2. 1955



Sec. **36** (Blk. **34** (Sur. **11W** Map No.

Well No. **1** Farm **Kastens**

Elev.	Location	NW	EW	NE
-------	----------	----	----	----

[illegible]

330 Ft. From N Line NW

330 Ft. From **VI** Line Quarter

1st. Report JAN 12 1955

Completion

Remarks Continental - DEIM

Co. tools

Spudding Date **1-11-55**

Drq. Data **Wildcat**

FABEN GILSTRAD