


Section 36 Township 34 Range 16TH

Well No. #1 Ballet

Company Falcon-Seaboard
Wildcat

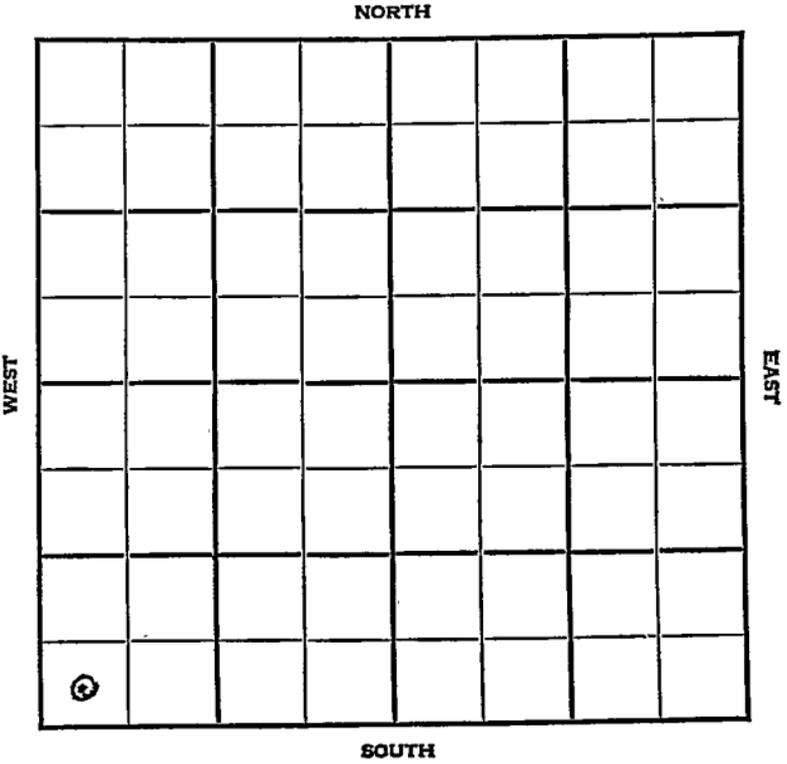



Sec. 36 Twp. 34 R. 16W

Well No. #1 Ballet Farm

Falcon-Seaboard Company


_____ Ft. from N. Line

330' Ft. from S. Line

_____ Ft. from E. Line

330' Ft. from W. Line

SW/C

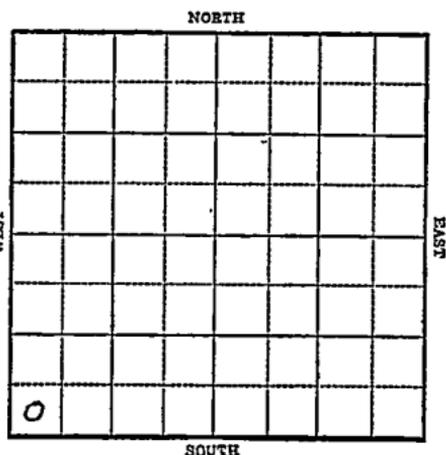

1948

~~Elev. 2980'~~ R E P O R T

1815 L+5

3/24

RUR

3/31

Surface Hole

4/7

8" @ 1107'
Drlg. 2390'

4/14

Drlg. 3595'

4/21

Lansing 4464'
Drlg. 4673'

4/28

Mississippi 5142'
Drlg. 5216'

5536 ✓
7815
3721

4464 L
7815
2679

5/5

Viola 5536'
Drlg. 5647'

5142 M
1815
3327

5/12

7" @ 2635'
151' of 5" perf. liner @ 2767'
17,000 acid
18,631,000 gas.
369# R. Pr.
TD 2767'
Comp.

COMPLETED

Map No. _____ Sec. 36 Twp. 34 R. 16W

Well No. 1 Ballet

Falcon-Seaboard Company

-IRST REPORT

Contractor

SW/C

SECTION PLAT

_____ Ft. from N. Line

330 Ft. from S. Line

_____ Ft. from E. Line

330 Ft. from W. Line

Comanche County

Location _____

Rig up _____

Drilling and Remarks:

R U R

RECORD

Cased: _____ in., _____ ft.

Sand _____

Gas _____

Oil _____

Total Depth _____

PRODUCTION

1st 24 hrs. Nat. _____

1st 24 hrs. after shot _____

Gas _____ Cu. Ft.

Dry Hole _____

Abandoned _____

Date

MAR 24 1948

19

S. J. LEWIS

Scout

