


Meade

KANSAS

SECTION 36 TOWNSHIP 34S RANGE 26W

WELL NO. #1 Theis "H"

COMPANY Northern Natural & Skelly

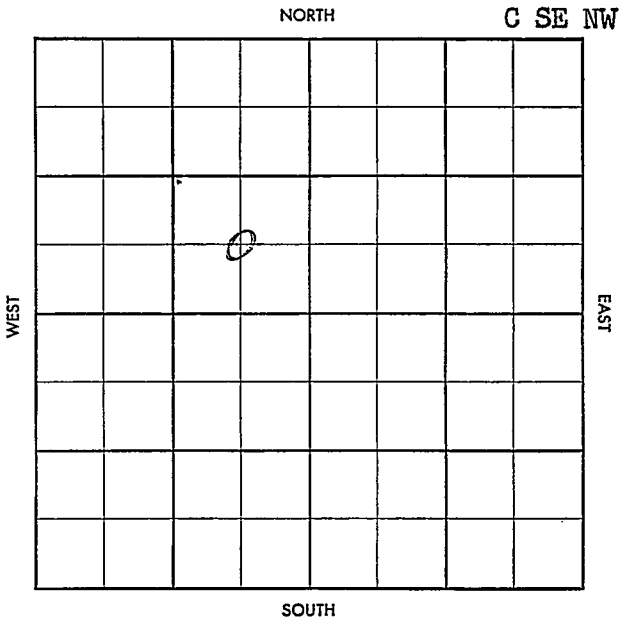

S-513-B

~~201~~ ~~202~~ ~~203~~  
~~204~~ ~~205~~ ~~206~~ ~~207~~ ~~208~~  
Facet **23**

County Meade Elev. \_\_\_\_\_  
Sec. 36 Twp. 34 Rge. 26W  
Company Northern Natural & Skelly  
Farm Name Theis "H" No. 1

TOPS	DEPTH	LOG	DATUM
Anh.			
Tp.			
H.			
Tr.			
Dg.			
B.L.			
L.			
K.C.			
B.K.C.			
Ce.			
C.			
M.			
M.			
K.			
Mz.			
Mq.			
V.			
S.			
S.			
A.			
R.			
Pf.			
G.			
T.D.			

Loc. in Sec. \_\_\_\_\_  
**G SE NW**  
Geol. \_\_\_\_\_  
Contr. \_\_\_\_\_  
Pool \_\_\_\_\_  
**McKinney**

**FIRST REPORT**  
MAY 1 1958

Date Comm. \_\_\_\_\_  
**Location**  
\_\_\_\_\_  
\_\_\_\_\_  
Co.  
Lse.  
No.  
Sec.  
T.  
R.

~~Top~~ ~~Post~~  
~~Co.~~ ~~Facet~~

5-313-B

County Meade Elev 2154 OF 2157  
 Sec 30 Twp 34 Rge 26W  
 Company Northern Natural & Skelly  
 Form Name Thisis "H" No. 1

TOPS	DEPTH	LOG	DATUM
Abh			
To			
Tb	4420	4432	
Tc	4448		
Do	659	4605	
B.L	7264	5307	
L	MD15H 5924	5820	
K.C	MD52	5886-94	
B.K.C	4257	5928	
Ce	100	5963-65	
C			
M	5998		
M			
K			
Mz			
Ma			
V			
S			
S			
A			
R			
Pf			
G			
ID	6060		

Loc. in Sec. C SE NW  
 Geol. \_\_\_\_\_  
 Contr. \_\_\_\_\_  
 Reol. McKinney  
 COMPLETE  
 0  
 SEP 17 '58

Date Comd. 5-24-58  
 Location MAY 21 '58 13" 468/325  
Ø 520 JAN 3 '58 8" 1136/680 Ø 3010  
JUN 11 '58 Ø 5276 JUN 18 '58 Cnd 5845-85  
 net 40' 14'sh 4'Li 1'sh 5'Li 1'sh  
 3'Li 2'ss 1'sh sdy 5'sh 1'Li 3'ss  
 Ø 51'sh Ø ST 5885-5952 Ø 75" 140"  
 netly gem FP 5075 BHP 1135/60"  
 Ø ST 5950-6010 Ø 90" 9/15" ga  
 netly re 180' H gem FP 65-31.0

Co. No. Sec. T. R.

BHP 1750/30 06031 JUN 25 '58

56015/250 JUL 2 '58 JUL 9 '58

JUL 18 '58 CO 5989 12/5981-84

dry 40/5964-74 A

dry 1/5967 1/5972 A ga

220 MCF f/c 10x10 ga 10.3 MCF

+ 3 BW ph NT vis 59 A ga 98

dry + 3 BW 24 hrs JUL 23 '58 B & P

5904 32/5886-94 A ga

179 MCF 1 hr + 57 g JUL 30 '58 fine

30x15 2 hr B/O down 1.032

MCF thru + 6 g WOP SI

AUG 9 '58 AUG 13 '58 AUG 20 '58 AUG 27 '58 SEP 3 '58

SEP 10 '58 3.055 MCF 2 1/2 hrs

ST 26 1.992 MCF 5 hrs SEP 17 '58

1.992 MCF 5 hrs

¢