


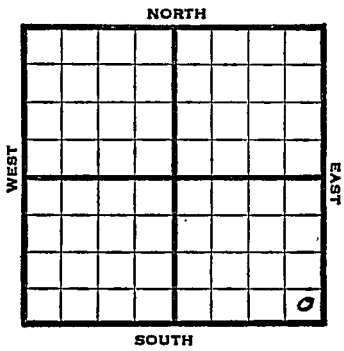

Sec. 36 Twp. 34 R. 30-W

Well No. #2 Adams Farm  
Helmerich & Payne etal Company

         Ft. from N. Line  
330 Ft. from S. Line  
330 Ft. from E. Line  
         Ft. from W. Line  
SE/c



1947	Elev. 2519' REPORT
4/9	Location
4/15	Drlg. 2465'
4/26	9" @ 2864' WOC
4/29	Drlg 3415'
5/7	Drl.g 4585'
5/13	Drlg 5240'
5/20	Drlg 5840'
5/27	Miss 5904' Drlg. 6312'
6/3	Drlg. 6432'
6/10	5" @ 6431' RUST
6/17	TD 6434'
6/24	"
7/1	"

OVER

1947

7/8 TD 6434'

7/16 "

7/22 "

7/29 "

8/6 Squeeze

8/13 Miss 5904  
Sol 6195'  
5" @ 6431'  
T.D. 6434'  
Abandoned

ABANDONED

5  
2519  
3285

Map No. \_\_\_\_\_ Sec. 36 Twp. 34 R. 30WWell No. 2 AdamsHelmerich & Payne et al. Company

## FIRST REPORT

Contractor

SE/C

## SECTION PLAT

\_\_\_\_\_ Ft. from N. Line

330 Ft. from S. Line330 Ft. from E. Line

\_\_\_\_\_ Ft. from W. Line

			o

Meade County

Location X

Rig up \_\_\_\_\_

Drilling and Remarks:

## RECORD

Cased \_\_\_\_\_ in., \_\_\_\_\_ ft.

Sand \_\_\_\_\_

Gas \_\_\_\_\_

Oil \_\_\_\_\_

Total Depth \_\_\_\_\_

## PRODUCTION

1st 24 hrs. Nat. \_\_\_\_\_

1st 24 hrs. after shot \_\_\_\_\_

Gas \_\_\_\_\_ Cu. Ft.

Dry Hole \_\_\_\_\_

Abandoned \_\_\_\_\_

Date

APR 9 1947 19S. J. LEWIS

Scout

Misc. Small Maps 2  
 Cards Book  
 Tracing ←  
 France Map ←  
 Scarborough Map X  
 Pierce Map X  
 Geological Dept. \_\_\_\_\_  
 Pierce Plat Book \_\_\_\_\_



*no work*

Misc. Small Maps

Cards

Tracing

France Map

Scarborough Map

Pierce-Map

Geological Dept.

Pierce Plat Book