FORM 51


Seward

KANSAS

Section 36 Township 34 Range 32W

Well No. #2 Woods

Company Lansekan

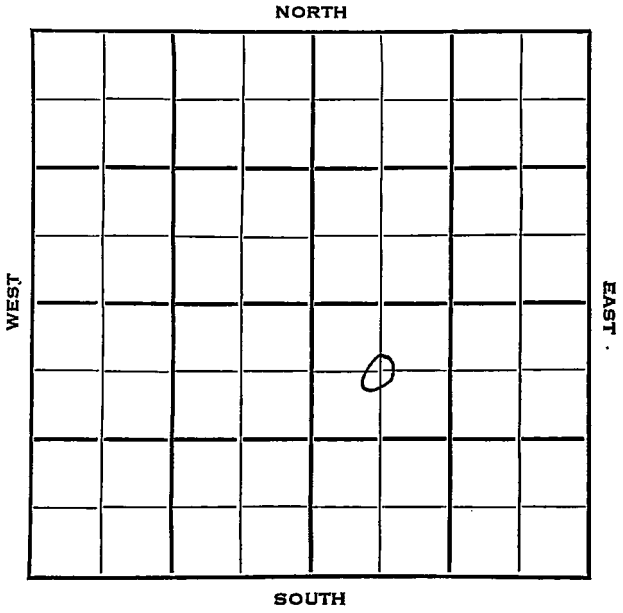

HOT FILE Seward KANSAS

FORM 252-B

Sec. 36 Twp. 34 R. 32 W

Well No. # 2 Woods Farm

Lansekan Company

Shaeffer Drlg. Contractor


660 Ft. from N. Line

Ft. from S. Line

Ft. from E. Line

660 Ft. from W. Line

C NW SE
MCPC has NW of 26

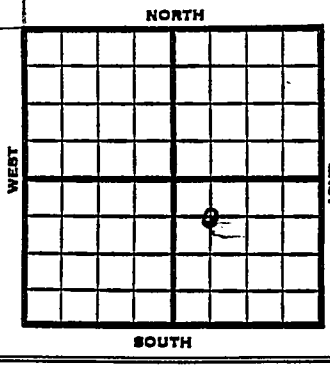

	REPORT
1953	Elev. 2724'
8/12	Spud 8-7-53 13" @ 650 Drlg. 1654'
8/19	N.R.
8/25	Set 8" @ 2563' Drlg. 3585' (Ltr-McGehee)
9/3	Drlg. 4532' " "
9/9	Drlg. 5139'
9/17	D & A " "
9/23	"
9/30	"
10/7	"
10/14	"
10/21	Spud 8-7-53 D & A TD 5355' 13" @ 650' 8" @ 2563' DST 4661'-81' opn 1 hr, rec 878' SW 1395# DST 5111'-31' opn 1 hr, rec 150' sw 267' mcsw 630# TD 5355' Lans 4421, Marm 5220' D & A

ABANDONED

FORM 275 FOR SALE BY KANSAS BLUE PRINT CO.


County Seward State Kansas

Sec. 36 (Blk. Twp.) 34 (Sur. Rge.) 32W Map No.

Operator Lansekan

Well No. 2 Farm Woods

Elev. Location C NW SE

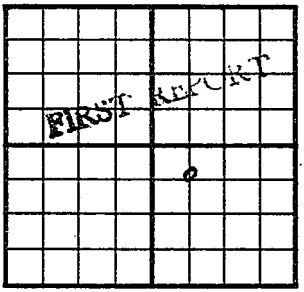

660 Ft. From N Line SE

660 Ft. From W Line Quarter

1st. Report AUG 12 1953

Completion

Remarks MCPC has NW of 26
Shaeffer Drlg. - Contr.

Spudding Date 8-7-53

Drlg. Data

13" @ 650 drlg. 1654

J. G. McGEHEE

FORM 275 FOR SALE BY KANSAS BLUE PRINT CO.


County Seward State Kansas

Sec. 36 (Blk. Twp.) 34 (Sur. Rge.) 32W Map No.

Operator Lansekan

Well No. 2 Farm Woods

Elev. 2724 Location C NW SE

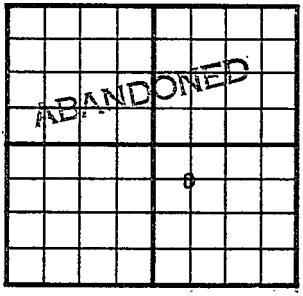

660 Ft. From N Line SE

660 Ft. From W Line Quarter

1st. Report

Completion OCT 21 19[illegible]

Remarks

Shaeffer Drlg. - Contr.

Spudding Date 8-7-53

Drlg. Data D & A TD 5355

13" @ 650 8" @ 2563 DST 4661-81

open 1 hr. Rec. 878' sw 1395#

DST 5111-31 open 1 hr. Rec. 150' sw

267' mcsw 630# TD 5355

Lans. 4421 Marm. 5220

D & A

J. G. McGEHEE