


Section 36 Township 34 Range 32 W

Well No. # 3 Woods

Company Lansekan Oil

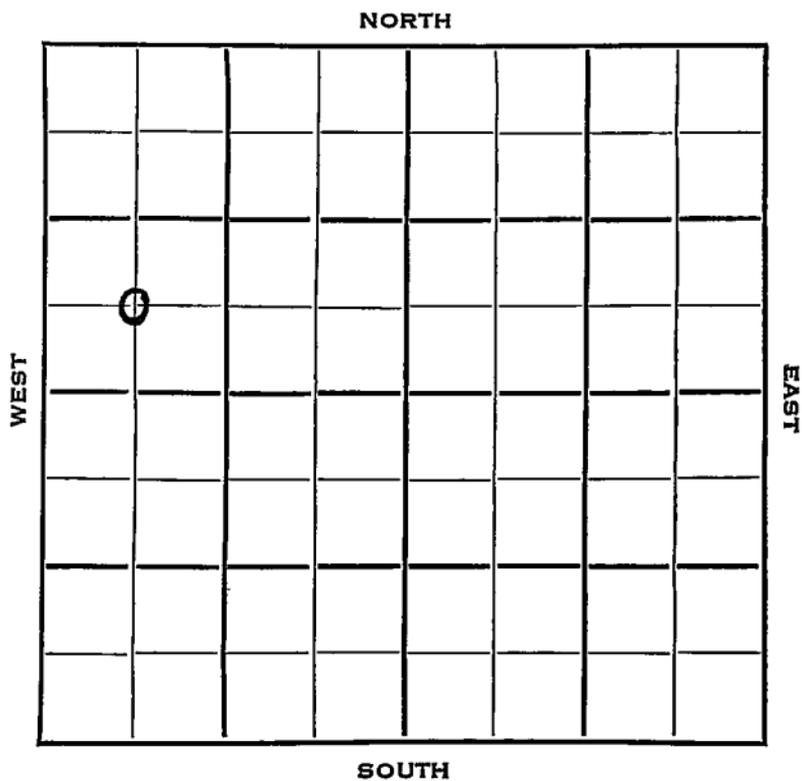

| | | |
|------|------|--------|
| SEC. | TWP. | R. |
| 36 | 34 | 32 W ✓ |


WELL NO. # 3 Woods FARM

COMPANY Lansekan Oil

CONTRACTOR

Liberal Light Pool

_____ Ft. from N. Line
 660 _____ Ft. from S. Line
 _____ Ft. from E. Line
 660 _____ Ft. from W. Line

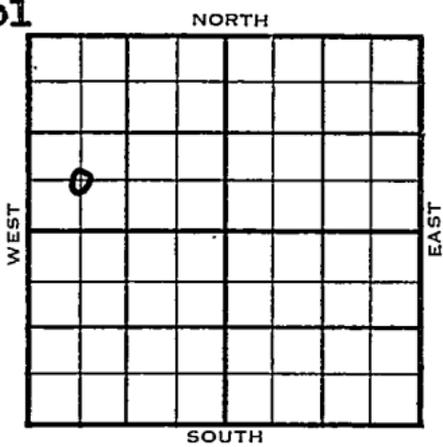

C SW NW
 Near MGPC Acreage

Acreage also

| | ELEVATION | REPORT |
|--|-----------|--------|
|--|-----------|--------|

| | | |
|-------|--|---------------|
| 1953 | 2736' | |
| 9/16 | Spud 9-14-53 | |
| 9/24 | Set 13" @ 648 8" @ 2590' | (Ltr-McGehee) |
| 10/1 | Lost hole at 3301' To skid the rig. | " " |
| 10/8 | Skid 50' east. Set 13" @ 676 w/525 sax. Drlg. 1961' | " " |
| 10/15 | Set 9" @ 2642' Drlg. 2803' | " " |
| 10/21 | KC 4424' Drlg 4608' | |
| 10/28 | N.R. | |
| 11/4 | " | |
| 11/11 | D & A | |
| 11/18 | " | |
| 12/9 | Spud 9-14-53 D&A TD 6102' 13" @ 648 8" @ 2590' TD 3301, lost hole, skid 50' east 13" @ 666' | |

L953
12/9

(Information Brought Forward)

13" @ 676

(" @ 2642' -

KC 4424'

DST 6045-75', opn 1 hr., rec. 480'

gscm,

TD 6102'

Miss 6070', Kri 2663', Win 2741', Ft.

Riley 2800', Lans 4414', Marm. 5278',

Cherokee 5486', Atoka 5758', Morrow

5875', Miss 6071'

D&A

ABANDONED

Socut Cards *mm*

Latid Small Map

Land Wall Map

Tracings

France Map

Pierce Map

Misc.

SEP 18 1953

Dirg. Date

1903

| | |
|-----------------|-------|
| Swain Carie | |
| Land & Coal Man | |
| Land Wall Map | |
| Tracings | |
| France Map | |
| Horse Map | |
| Misc. | |