


Seward **KANSAS**Section 36 Township 34 Range 34WWell No. #1 Air PortCompany Northern Ordnance

NORTH

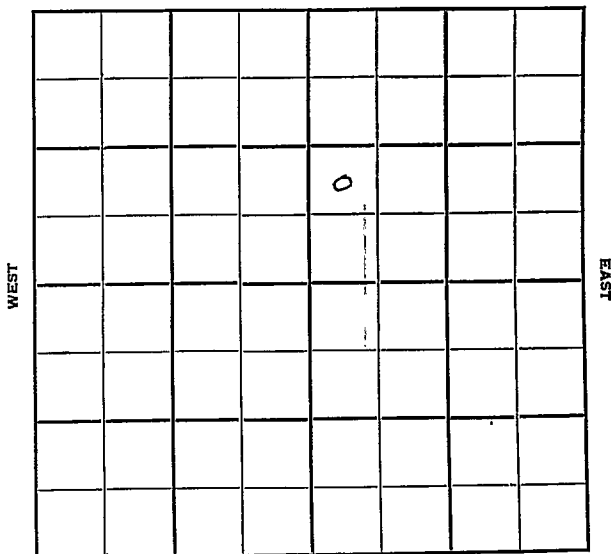

SOUTH

Seward KANSAS

Sec. 36 Twp. 34 R. 34 W

Well No. # 1 Air Port Farm

Northern Ordnance Company

Contractor


1750 Ft. from N. Line

 Ft. from S. Line

2000 Ft. from E. Line

 Ft. from W. Line

NW SW NE

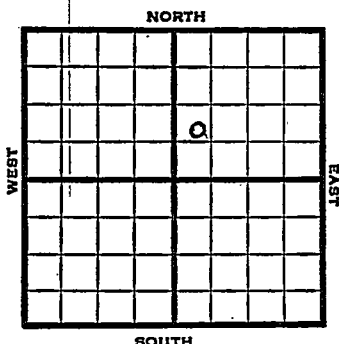


1951 Elev. 2878'8 REPORT

3/7 Spud 2-27-51
8" @ 705'
Drilling 2600'

4/18 Spud 2-27-51
Gas Well TD 2780
8" @ 705
Her 2606 Krider 2665
Win. 2717
5" @ 2769 TD 2780
8/2730-32 18/2718-28 20/2721-26
80/2669-89 11,000 A
Comp. 16,400,000 gas 365#

COMPLETED

County Seward State Kansas
 Sec. 36 (Blk. Twp.) 34 (Sur. Rge.) 34W Map No. _____
 Operator Northern Ordnance
 Well No. 1 Farm Air Port
 Elev. _____ Location NW SW NE

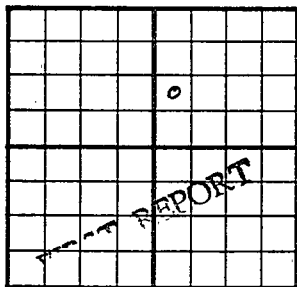

1750 Ft. From N Line NE
2000 Ft. From E Line Quarter
 Ist. Report MAR 7 1951
 Completion _____
 Remarks _____
 Spudding Date 2-27-51

Drlg. Data

8" @ 705 drlg. 2600

J. E. TYRA

Scout Cards	<i>m m</i>	MAR 9	1951
Land Sheet Map			
Land Wall Map			
Tracings			
France Map			
Pierce Map			
Misc.			

Orig. Data

J. E. TYRA

Scout Cards	
Land Small Map	
Land Wall Map	5
Tracings	
France Map	
Pierce Map	
Misc.	

APR 24 1957