


Morton

KANSAS

SECTION 36 TOWNSHIP 34 RANGE 42W

WELL NO. #4 Bennett "B"

COMPANY Panhandle Eastern

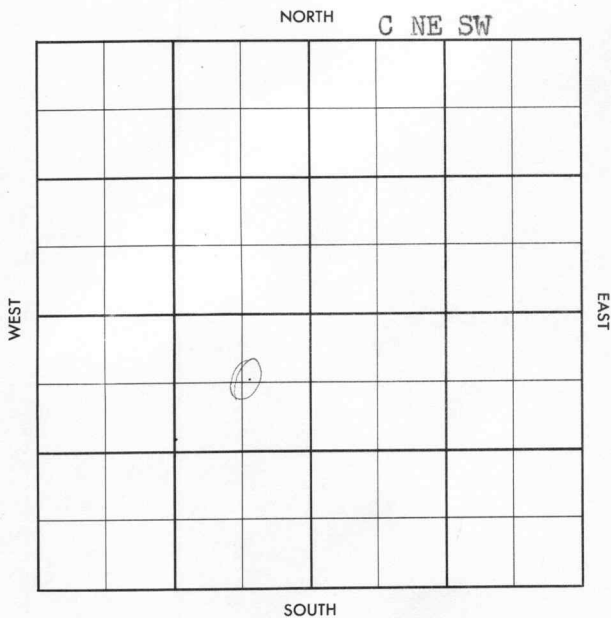

County Morton Elev. _____
Sec. 36 Twp. 34 Rge. 42W
Company Panhandle Eastern
Farm Name Bennett "B" No. 4

TOPS	DEPTH	LOG	DATUM	Loc. in Sec.
Anh.				C NE SW
Tp.				
H.				
Tr.				
Dg.				
BL.				
L.				Geol. _____
K.C.				Contr. _____
B.K.C.				Nye & Snell
Ce.				Pool
C.				Taloga
M.				
M.				
K.				
Mz.				
Mq.				
V.				
S.				
S.				
A.				
R.				
PE.				
G.				
T.D.				

FIRST		B.P.P.	
		FEB 13 '57	

Date Comm. 2-6-57
8" @ 1495/825 drlg. 1496

34

34

County Morton Elev. 3508
 Sec. 36 Twp. 34 Rge. 42W
 Company Panhandle Eastern
 Farm Name Bennett "B" No. 0-4

TOPS	DEPTH	LOG	DATUM	Loc. in Sec.
Anh. <u>WA6</u>		<u>2805</u>		<u>C NE SW</u>
Tr.		<u>3018</u>		
H.				
Tr.				
Dg.				
BL.				
L. <u>-CSO</u>		<u>3285</u>		Geol.
K. <u>LS9</u>		<u>3512</u>		
B.K.C.				Contr.
Ce.		<u>4244</u>		
C.				<u>Nye & Snell</u> Fls
M. <u>MW 5h</u>		<u>4549</u>		
M. <u>" 5d</u>		<u>4652-66</u>		Pool
K. <u>" 5d</u>		<u>4952-71</u>		
Mz. <u>" 5d</u>		<u>4973-86</u>		<u>Taloga</u>
Mo. <u>Keyes</u>		<u>5014-76</u>		
V. <u>Miss</u>		<u>5103</u>		ABANDONED MAR 16 '57
S.				
S.				
A.				
R.				
Pe.				
G.				No.
TD	<u>5132</u>			

Date Comm. 2-6-57

8" @ 1495/825 drlg. 1496 FEB 20 '57 3737

FEB 27 '57 DST 4622-60 1hr 15'

Md FP 17-35 BHP 35/20

DST 4659-4701 1hr 25'

DST cut mud BHP 55/25"

Fshg @ 4925 MAR 6 '57 DST 5059

-67 1hr 35' H6CM + 1075' H6CSW

FP 200-580 BHP 1140/20" DST

5109-32 1hr 15' Mo BHP 60/20"

DEA