


KANSAS Stevens

FORM 51 5M 11-44 PETROL

Section 36 Township 34 Range 3 CONT

Well No. 1 Rickart

Company Herrington & Marsh

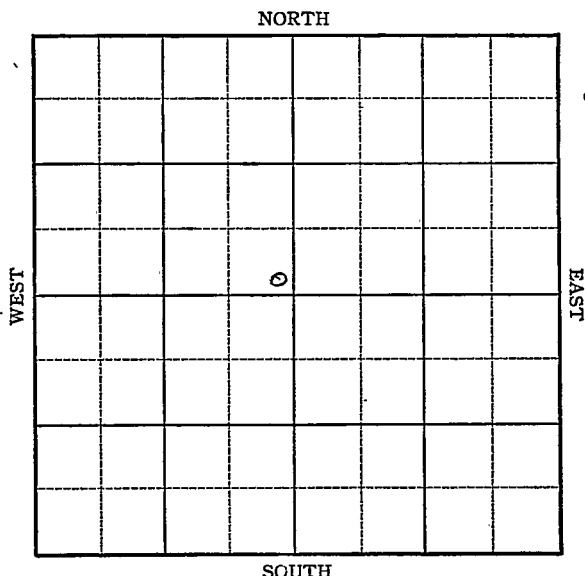

KANSAS

Stevens County

Sec. 36 Twp. 34 R. 39WWell No. #1 Rickart FarmHerrington & Marsh Company

Hugoton

Ft. from N. Line

100


Ft. from S. Line

100

Ft. from E. Line

Ft. from W. Line

SE NW Elev. 3282

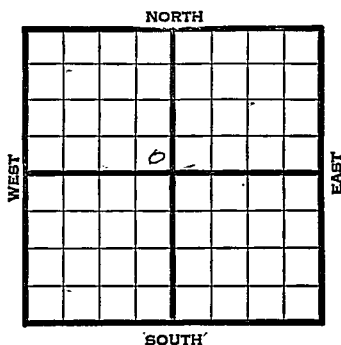

REPORT

1945

7/25

Location

8/1

Drlg. 55'

8/8

10" @ 605

Drlg. 2239

8/15

7" @ 2644

TD 2653 RUST

8/22

" " "

8/29

" " "

9/5

" " "

9/12

" " "

9/19

Drlg. 2740

9/26

TD 2766

169' of 5" Perf. liner @ 2766

3-8/10 M Gas.

10/3

" " " " "

10/10

TD 2766'

169' of 5" Perf. liner @ 2766

10/17

" " " " "

10/24

" " " " "

10/31

TD 2766

11/7

" "

11/14

" "

11/21

" "

11/28

14,000 acid.

12/5

" "

12/12

" "

OVER

1945

12/19 7" @ 2644
169' of 5" Perf. liner @ 2766
14,000 acid.
TD 2766
29,292,000 Gas.
381# R Pr.

COMPLETED

KANSAS Pool Name. HugotonMap No. no map Sec. 36 Twp. 34 R. 39WWell No. 1 RickartHerrington & Marsh Company

FIRST REPORT

Contractor

SE NW

SECTION PLAT

 Ft. from N. Line100 Ft. from S. Line100 Ft. from E. Line Ft. from W. Line

Stevens County

Location XRig up Drilling and Remarks:

RECORD

Cased in., ft.Sand Gas Oil Total Depth

PRODUCTION

1st 24 hrs. Nat. 1st 24 hrs. after shot Gas Cu. Ft.Dry Hole Abandoned

Date

JUL 25 1945 19

S. J. LEWIS Scout

Handwritten scribble or signature

Misc. Small Maps	<i>Handwritten mark</i>
Cards	<i>Handwritten signature</i>
Tracing	
France Map	<i>X</i>
Scarborough Map	<i>X</i>
Moody Map	
Geological Dept.	
Moody Plat Book	


KANSAS Kansas Pool Name EugotonMap No. 16 map Sec. 36 Twp. 34 R. 39WWell No. 1 RickartHerrington & Marsh Company**COMPLETED**

Contractor

SE NW

21,3282
SECTION PLAT Ft. from N. Line100 Ft. from S. Line100 Ft. from E. Line Ft. from W. Line

Stevens County

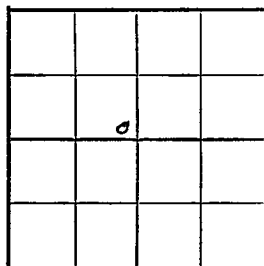Location Rig up

Drilling and Remarks:

7" @ 26 #4
 169' 2 1/2" liner @
 2766
 14,000 @ 26 #4
 29,292,000 Gas
 387 # R/P2

RECORDCased in., ft.Sand Gas Oil Total Depth 2766**PRODUCTION**1st 24 hrs. Nat. 1st 24 hrs. after shot Gas Cu. Ft.Dry Hole Abandoned

Date

DEC 19 1945 19

S. J. LEWIS

Scout

no wall

Misc Small Maps	☒
Cards	☒
Tracing	☒
France Map	☒
Scarborough Map	☒
Pierce Map	☒
Geological Dept.	☐
Pierce Plat Book	☐