

23-34-38W

**KANSAS DRILLERS LOG**

S. 23 T. 34S R. 38 E  
 Loc. 2540' FNL & 1250' FEL

API No. 15 — 189 — 20,266  
 County Number

County Stevens

Operator  
 Anadarko Production Company

Address  
 Box 351, Liberal, Kansas 67901


Well No. #1 Lease Name Burrows "A"

Footage Location  
 2540 feet from (N) (S) line 1250 feet from (E) (W) line

Principal Contractor Gabbert-Jones, Inc. Geologist

Spud Date 2-28-75 Total Depth 3035'

Date Completed 3-22-75 Oil Purchaser

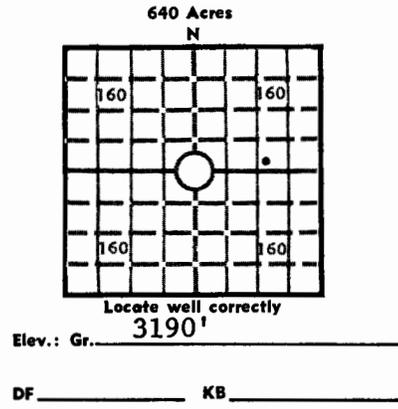

**CASING RECORD**

Report of all strings set — surface, intermediate, production, etc.

Purpose of string	Size hole drilled	Size casing set (in O.D.)	Weight lbs/ft.	Setting depth	Type cement	Sacks	Type and percent additives
Surface	12-1/4"	8-5/8"	20#	643'	Common	500	3% CC
Production	7-7/8"	4-1/2"	10.5#	3035'	Lite Wate Pozmix	550 150	4% Gel-12 1/2 # Gil 18% salt .5% CFR2

**LINER RECORD**

**PERFORATION RECORD**

Top, ft.	Bottom, ft.	Sacks cement	Shots per ft.	Size & type	Depth interval
			3 SPF		2957' - 3006' OA

**TUBING RECORD**

Size	Setting depth	Packer set at
2-3/8"	2967'	

**ACID, FRACTURE, SHOT, CEMENT SQUEEZE RECORD**

Amount and kind of material used	Depth interval treated
Acidized w/2000 gallons 15% + 125 ball sealers. Fraced w/80,000 gallons water + 60,000# Riversand.	2957' - 3006' OA

**INITIAL PRODUCTION**

Date of first production SI for Pipeline Connection		Producing method (flowing, pumping, gas lift, etc.) Flowing			
RATE OF PRODUCTION PER 24 HOURS	Oil bbls.	Gas COF 1709	Water MCF	Gas-oil ratio bbls.	CFPB
Disposition of gas (vented, used on lease or sold) Will be sold			Producing interval(s) 2957' - 3006' OA		

INSTRUCTIONS: As provided in KCC Rule 82-2-125, within 90 days after completion of a well, one completed copy of this Drillers Log shall be transmitted to the State Geological Survey of Kansas, 4150 Monroe Street, Wichita, Kansas 67209. Copies of this form are available from the Conservation Division, State Corporation Commission, 3830 So. Meridian (P.O. Box 17027), Wichita, Kansas 66217. Phone AC 316-522-2206. If confidential custody is desired, please note Rule 82-2-125. Drillers Logs will be on open file in the Oil and Gas Division, State Geological Survey of Kansas, Lawrence, Kansas 66044.

Operator  
**Anadarko Production Company**

DESIGNATE TYPE OF COMP.: OIL, GAS,  
 DRY HOLE, SWDW, ETC.:

Well No. #1      Lease Name **Burrows "A"**

Gas

S 23 T 34S R 38 ~~XK~~  
 W


**WELL LOG**

Show all important zones of porosity and contents thereof; cored intervals, and all drill-stem tests, including depth interval tested, cushion used, time tool open, flowing and shut-in pressures, and recoveries.

SHOW GEOLOGICAL MARKERS, LOGS RUN, OR OTHER DESCRIPTIVE INFORMATION.

FORMATION DESCRIPTION, CONTENTS, ETC.	TOP	BOTTOM	NAME	DEPTH
Surface Clay-Sand	0	620		
Redbed	620	648		
Redbed-Sand	648	1330		
Shale-Anhy	1330	1710		
Shale-Anhy-Sand	1710	1990		
Lime-Shale	1990	3035		
Total Depth		3035		

USE ADDITIONAL SHEETS, IF NECESSARY, TO COMPLETE WELL RECORD.

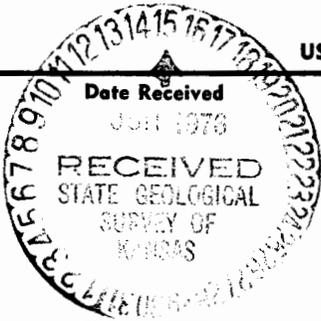

*T. W. Williams*  
 T. W. Williams      Signature

Division Office Supervisor

Title

April 11, 1975

Date

2-30-2850