

IMPORTANT
Kans. Geo. Survey request
samples on this well.

32-34-38W

KANSAS DRILLERS LOG

S. 32 T. 34 R. 38 W

API No. 15 — 189 — 20,386
County Number

Loc. C SE

County Stevens

Operator
Kansas Petroleum, Inc.

Address 200 East First, Suite 100 Wichita, Kansas 67202


Well No. #1 Lease Name Breckheisen

Footage Location
1320 feet from ~~XXX~~ (S) line 1320 feet from (E) ~~XXX~~ line

Principal Contractor Sage Drilling Company Geologist None

Spud Date 2/22/78 Total Depth 3125 P.B.T.D.

Date Completed 2/26/78 Oil Purchaser

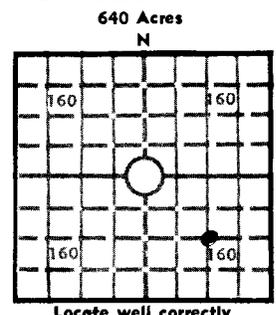

Locate well correctly
Elev.: Gr. 3240

DF KB 3245

CASING RECORD

Report of all strings set — surface, intermediate, production, etc.

Purpose of string	Size hole drilled	Size casing set (in O.D.)	Weight lbs/ft.	Setting depth	Type cement	Sacks	Type and percent additives
Surface	12 1/4"	8 5/8"		629	Pozmix	400	2% cc
Production	7 7/8"	5 1/2"	14#	3124	Pozmix	600	18% Salt

LINER RECORD

PERFORATION RECORD

Top, ft.	Bottom, ft.	Sacks cement	Shots per ft.	Size & type	Depth interval
None				2960-65	3069-3074
				2983-88	
				2992-99	
				3014-20	
				3043-55	

TUBING RECORD

Size	Setting depth	Packer set at

ACID, FRACTURE, SHOT, CEMENT SQUEEZE RECORD

Amount and kind of material used	Depth interval treated
2500 Gallons 15% MCA	
2630 Barrels of gelled water and 150,000 # of sand	2960-3074

INITIAL PRODUCTION

Date of first production <u>3/20/78</u>	Producing method (flowing, pumping, gas lift, etc.) <u>Pumping</u>			
RATE OF PRODUCTION PER 24 HOURS	Oil	Gas	Water	Gas-oil ratio
	bbls.	MCF	bbls.	CFPB
Disposition of gas (vented, used on lease or sold)		Producing interval (s) <u>2960-3074</u>		

INSTRUCTIONS: As provided in KCC Rule 82-2-125, within 90 days after completion of a well, one completed copy of this Drillers Log shall be transmitted to the State Geological Survey of Kansas, 4150 Monroe Street, Wichita, Kansas 67209. Copies of this form are available from the Conservation Division, State Corporation Commission, 3830 So. Meridian (P.O. Box 17027), Wichita, Kansas 66217. Phone AC 316-522-2206. If confidential custody is desired, please note Rule 82-2-125. Drillers Logs will be on open file in the Oil and Gas Division, State Geological Survey of Kansas, Lawrence, Kansas 66044.

Operator

Kansas Petroleum, Inc.

DESIGNATE TYPE OF COMP.: OIL, GAS, DRY HOLE, SWDW, ETC.:

Well No. 1

Lease Name Brecheisen #1

Gas

S 32 T 34 R 38 E W

WELL LOG

Show all important zones of porosity and contents thereof; cored intervals, and all drill-stem tests, including depth interval tested, cushion used, time tool open, flowing and shut-in pressures, and recoveries.

SHOW GEOLOGICAL MARKERS, LOGS RUN, OR OTHER DESCRIPTIVE INFORMATION.

FORMATION DESCRIPTION, CONTENTS, ETC.	TOP	BOTTOM	NAME	DEPTH
Sand and Red Bed	0	635		
Shale	635	960		
Shale and Sand	960	1445		
Shale	1445	1802		
Shale and Lime	1802	2075		
Lime and Shale	2075	2440		
Shale and Lime	2440	2640		
Lime and Shale	2640	3025		
Lime	3025	3125		
5 1/2" set @ 3124' w/600 sax cement				

USE ADDITIONAL SHEETS, IF NECESSARY, TO COMPLETE WELL RECORD.

Date Received

James D. ...
Signature

President, Kansas Petroleum, Inc.

Title

January 23, 1979

Date