


Section 4 Township 34 Range 8-W

Well Number 1 Seibert

Company Carter & Stanolind

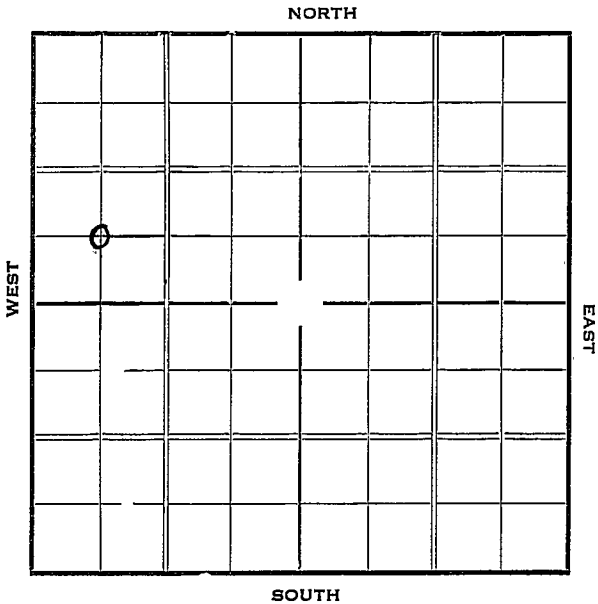

*Special*



1937

5/28 Sil. 5202' (Corrected)  
6" @ 4680'. Shot 58 qts.  
6/4 T.D. 4670'. Show 20 qts.  
2000 acid.

6/9 6" @ 4680'.  
Sil. 5202'.  
T.D. 5220'.  
P.B. 4628'.

**ABANDONED**

:

*Hayer* **KANSAS**

Map No. 33 Sec. 4 Twp. 34 R. 8W

Well No. 1-Seibert

Carter & Stanolind Company

Contractor

**ABANDONED**

**SECTION PLAT**

\_\_\_\_\_ Ft. from N. Line

660 Ft. from S. Line

\_\_\_\_\_ Ft. from E. Line

660 Ft. from W. Line

0			

Location \_\_\_\_\_

Rig up \_\_\_\_\_

Drilling and Remarks:

*P.B. 4628*

*DKA*

**RECORD**

Cased 6 in., 4680 ft.

Sand 511 5202

Gas \_\_\_\_\_

Oil \_\_\_\_\_

Total Depth 5220

**PRODUCTION**

1st 24 hrs. Nat. \_\_\_\_\_

1st 24 hrs. after shot \_\_\_\_\_

Gas \_\_\_\_\_ Cu. Ft.

Dry Hole \_\_\_\_\_

Abandoned \_\_\_\_\_

Date

JUN 9 1937 19

H. D. Hatfield

Scout

# KANSAS

Map No. 33 Sec. 4 Twp. 34 R. 8W

Well No. 1 Seibert

Carter & Standhind Company

Contractor

## Special

### SECTION PLAT

\_\_\_\_\_ Ft. from N. Line

660 Ft. from S. Line

\_\_\_\_\_ Ft. from E. Line

660 Ft. from W. Line

o			

### FIRST REPORT

Location ✓

Rig up \_\_\_\_\_

Drilling and Remarks:



### RECORD

Cased \_\_\_\_\_ in., \_\_\_\_\_ ft.

Sand \_\_\_\_\_

Gas \_\_\_\_\_

Oil \_\_\_\_\_

Total Depth \_\_\_\_\_

### PRODUCTION

1st 24 hrs. Nat. \_\_\_\_\_

1st 24 hrs. after shot \_\_\_\_\_

Gas \_\_\_\_\_ Cu. Ft.

Dry Hole \_\_\_\_\_

Abandoned \_\_\_\_\_

Date

FEB 10 1937  
19

S. J. LEWIS Scout