
Clark **KANSAS**

SECTION 4 TOWNSHIP 34 RANGE 25W

WELL NO. #1 Paul Harden G.U. #2

COMPANY Atlantic

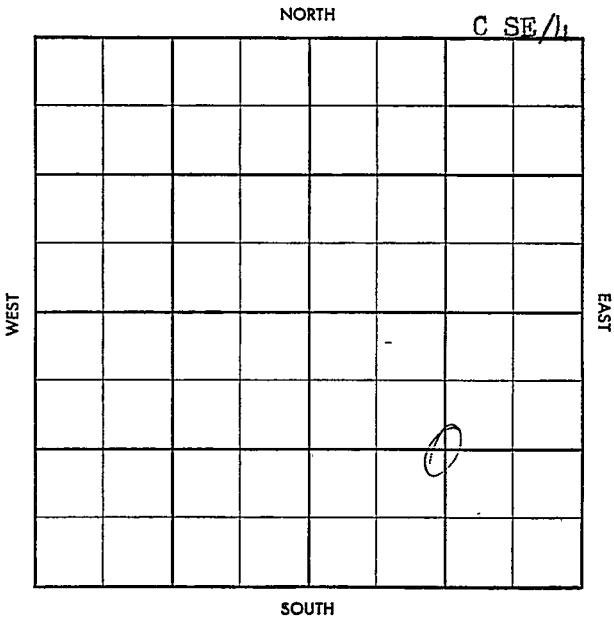

FORM 504-3 SUNRAY

S-513-A

CO. Clark ELEV.

SEC. 4 TWP. 34 RGE. 25W

COMPANY Atlantic NO. 1

FARM Paul Harden G.U. #2

LOC. C SE/4

GEOL.

CONTR. Langford Tools

POOL McKinney

SPUD

RURT

FIRST REPORT

OCT

CO.

LSE.

NO.

SEC.

TWP.

RGE.

K-24

S-513-A

CO. Clark ELEV 2081DF ABANDONED

SEC. 4 TWP. 34 RGE. 25W

COMPANY Atlantic NO. 1

OCT 30 '57

FARM Paul Harden G.U. #2

LOC. C SE/4

GEOL.

CONTR. Langford Tools

POOL McKinney

SPUD 10-1-57

RLRT OCT 9 '57

6s 3/400 D 2600

OCT 16 '57 #4780

OCT 22 '57 H64264

Lsg 4390 Mor

5485 Miss 5504

DST 5507-90 60" WB

15' M FP 10-20 BHP 30/30"

DST 5591-5655 60" 15' M

FP 10-20 BHP 10-20/30"

DST 5650-5720 60" 30" M

FP 30-30 BHP 65-75/30"

RTD 5720 Ran Log Top

Lsg 4410 Mor 5464 M 5505

D-64

CO. LSE. NO. SEC. TWP. RGE.