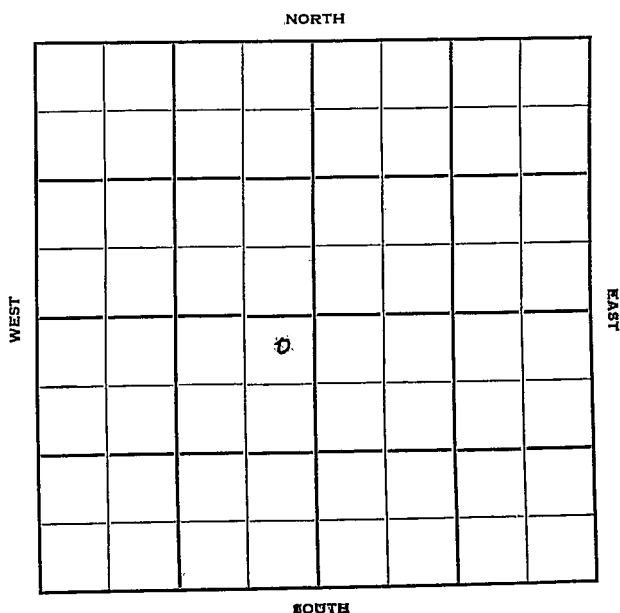


Section 4 Township 34 Range 33WWell No. #1 Graham "B"Company Cities Service

Seward

KANSAS

Sec. 4 Twp. 34 R. 33W

Well No. #1 Graham "B" Farm

Cities Service

Company

Carbour & Barber

Contractor

Hugoton Pool


100' Ft. from N. Line

 Ft. from S. Line

100' Ft. from E. Line

 Ft. from W. Line

NE SW

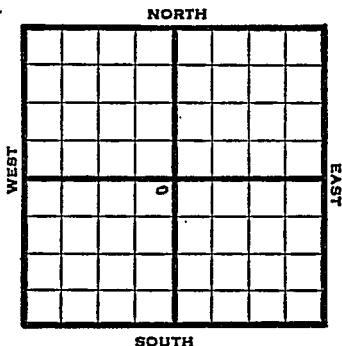

1950

Elev 2855'

REPORT

9/27

Location

1951

1/10

8" @ 680

TD 2990

5" @ 2789

Her 2622

Krider 2652

Win 2742

10/2720-22 SP 2744

140/2686-2714

60/2632-38 80/2654-64

22500 A

Comp 9,240,000 gas 299#

Completed

COMPLETED

Sec. 4 (Blk. 34 (Sur. 3 SW Twp.) Rge.) Map No.

Well No. 7 Farm Graham "R"

FIRST REPORT

~~700~~ Ft. From E Line Quarter

1st. Report SEP 27 1950

Completion

Remarks

Garhour & Barber - Contr.

Spudding Date _____

Drig. Data Hugoton Pool

Location _____

J. E. TYRA

Scout Cards	
Land Small Map	
Land Wall Map	
Tracing	
France Map	
Pierce Map	
Misc.	

SEP 29 1950

Drig. Data

County Seward State Kansas

Sec.	4	(Blk. Twp.)	34	(Sur. Rge.)	33W	Map No.
------	---	----------------	----	----------------	-----	---------

Operator Cities Service

Well No. 1 Farm Graham "B"

Elev.	2855	Location	NE SW
-------	------	----------	-------

100 Ft. From N Line SW

100 Ft. From E Line Quarter

1st. Report _____

Completion JAN 10 1951

Remarks Hugoton Pool

Barbour - Contr.

Spudding Date

Drilg. Data Gas well TD 2990

8" @ 680 TD 2990 5" @ 2789

Her. 2622 Krider 2652 Win. 2742

10/ 2720-22 SP 2744 140/ 2686-2714

60/ 2632-38 80/ 2654-64 22500 A

Comp. 9,240,000 gas 299#

J. E. TYRA

Scout Cards	7
Land on Map	3
Land on Map	
Tracings	
France Map	
Pierce Map	
Misc.	

JAN 19 1951

Orig. Data