

# KANSAS


FORM 51 25M 3-49 PETROL

Seward

Section 4 Township 34 Range 34-W

Well No. #1 Nix

Company Plains Natural Gas

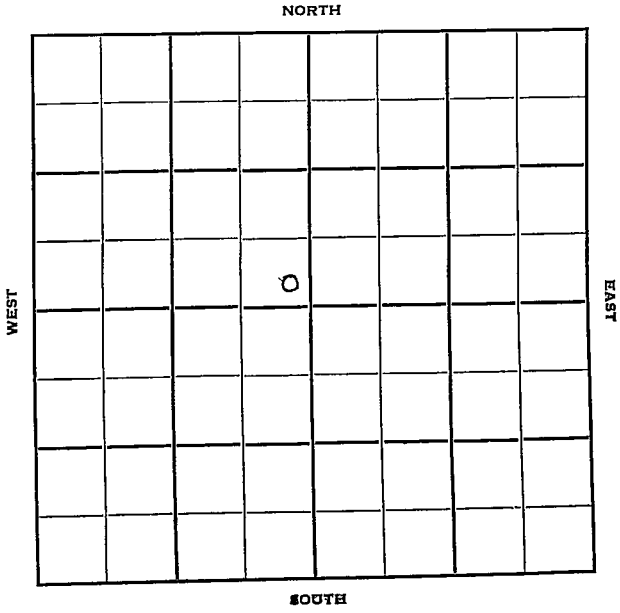

Seward

Sec. 4 Twp. 34 R. 34W

Well No. #1 Nix Farm

Plains Natural Gas Company

Midwestern Contractor

Hugoton Pool


Ft. from N. Line

200' Ft. from S. Line

200' Ft. from E. Line

Ft. from W. Line

SE NW

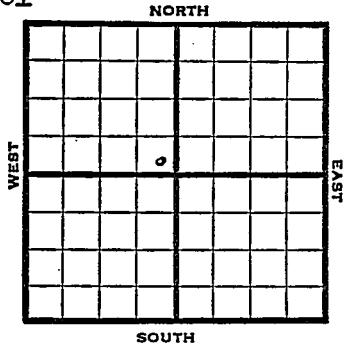

1950 Elev 2934 REPORT

9/13 Location  
 10/18 Spud 9-17-50  
 10" @ 693  
 Skid 10' south  
 10" @ 661  
 7" @ 2755  
 TD 2756  
 Hol 2570 Her 2626  
 Kirder 2660 Win 2739  
 240/2689-2729, 36/2662-68, 60/2630-46  
 30/2628-33, 78/2740-53  
 16000 total acid  
 Comp 8,708,000 gas  
 Completed  
**COMPLETED**



