

# KANSAS


Stevens

Section 4 Township 34 Range 35W

Well No. 1 Bane Unit

Company Texas

Hugoton NORTH

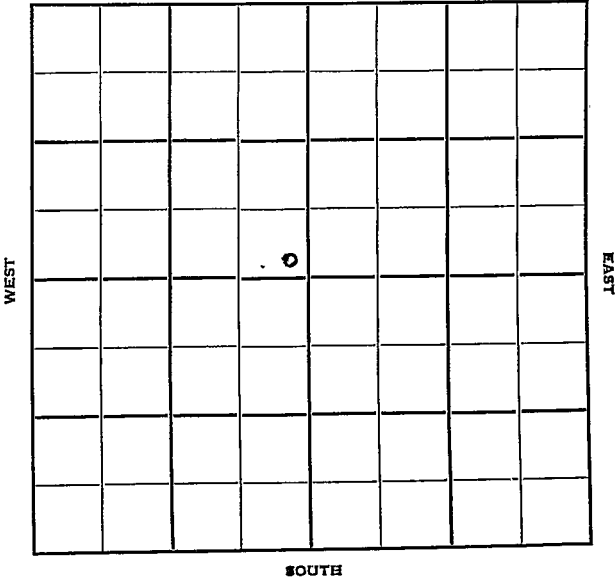

KANSAS

Stevens

Sec. 4 Twp. 34 R. 35W ✓

Well No. #1 Bane Unit Farm

Texas

Company

Hugoton Pool


NORTH

\_\_\_\_\_ Ft. from N. Line

100' Ft. from S. Line

100' Ft. from E. Line

\_\_\_\_\_ Ft. from W. Line

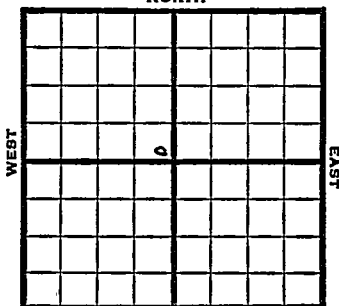

SE NW

1949 Elev. 2998' REPORT

4/5 10" @ 75'

4/10 TD 2804'

7" @ 2803'

5/18 "

5/25 "

6/1 458 shots 2650-2790 - 10,000 acid

6/7 "

6/15 5000 acid

6/22 7" @ 2803'

Perf.

Acid 15,000

Gas 16,344,000

R Pr. 400#

TD 2804'

**COMPLETED**

Kansas

Map No. \_\_\_\_\_ Sec. 4 Twp. 34 R. 35WWell No. 1 Bane Unit

\_\_\_\_\_ Texas \_\_\_\_\_ Company

\_\_\_\_\_ **FIRST REPORT** \_\_\_\_\_ Contractor

SE NW

## SECTION PLAT

\_\_\_\_\_ Ft. from N. Line

100 Ft. from S. Line100 Ft. from E. Line

\_\_\_\_\_ Ft. from W. Line


Stevens County

## RECORD

Location \_\_\_\_\_

Cased \_\_\_\_\_ in., \_\_\_\_\_ ft.

Rig up \_\_\_\_\_

Sand \_\_\_\_\_

Drilling and Remarks:

Gas \_\_\_\_\_

10" @ 725

Oil \_\_\_\_\_

Total Depth \_\_\_\_\_

## PRODUCTION

1st 24 hrs. Nat. \_\_\_\_\_

1st 24 hrs. after shot \_\_\_\_\_

Gas \_\_\_\_\_ Cu. Ft.

Dry Hole \_\_\_\_\_

Abandoned \_\_\_\_\_

Date

MAY 4 1949 19S. J. LEWIS

Scout

