

KANSAS


FORM 51 5M 11-44 PETROL

Stevens County

Section 4 Township 34 Range 36W

Well No. #2 Elmo-Lodge

Company Republic Nat. Gas

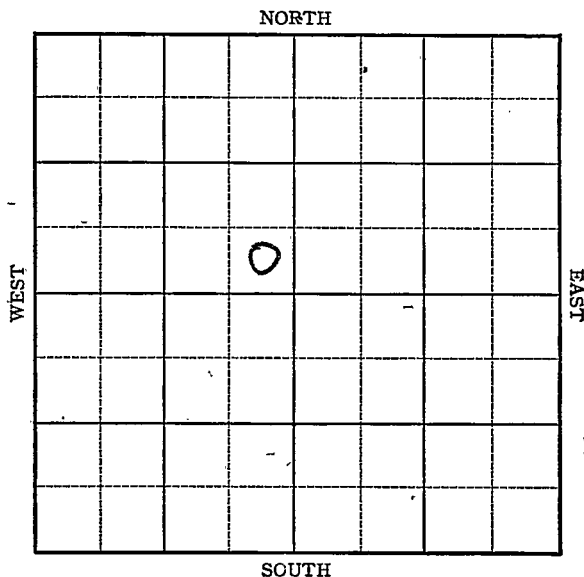

KANSAS

Stevens County



Sec. 4 Twp. 34 R. 36W

Well No. #2 Elmo-Lodge Farm

Republic Nat. Gas Company

Hugoton


Ft. from N. Line

350 Ft. from S. Line

350 Ft. from E. Line

Ft. from W. Line

SE NW

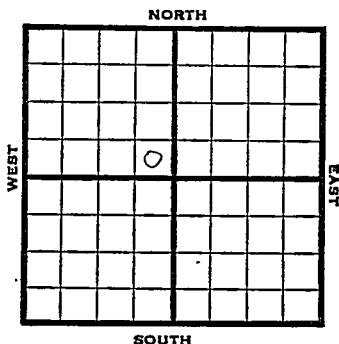

1946 Elv. 3085 REPORT

2/13 Location
2/21 10" - 697' Drlg. 2100'
2/28 T.D. 2694' 7" - 2684'
RUST.
3/7 "
3/14 T.D. 2823' 267' of 5" perf liner at 2823'
3/21 Total 12,500 acid.
3/28 " "
4/4 " "
4/10 7" @ 2684
267' of 5" perf. liner @ 2823
12,500 acid.
TD 2823
20,065,000 Gas.
386# R Pr.

COMPLETED

KANSAS

Kansas Pool Name HugotonMap No. 10mg Sec. 4 Twp. 34 R. 36WWell No. 2 Elmo-LodgeRepublic Nat. Gas CompanyFIRST REPORT Contractor

SE NW

SECTION PLAT

		0	

 Ft. from N. Line350 Ft. from S. Line350 Ft. from E. Line Ft. from W. LineStevens CountyLocation XRig up Drilling and Remarks:

RECORD

Cased in., ft.Sand Gas Oil Total Depth

PRODUCTION

1st 24 hrs. Nat. 1st 24 hrs. after shot Gas Cu. Ft.Dry Hole Abandoned

Date

FEB 13 1946 19 S. J. LEWIS Scout


KANSAS Kansas Pool Name HugotonMap No. None Sec. 4 Twp. 34 R. 36WWell No. 2 Elmo-Lodge

Republic Natural Gas Company

COMPLETED

Contractor

SE NW

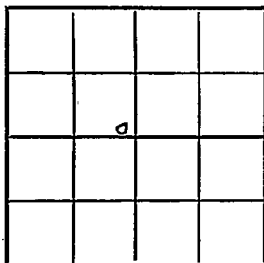E13085
SECTION PLAT Ft. from N. Line350 Ft. from S. Line350 Ft. from E. Line Ft. from W. Line

Stevens County

Location Rig up

Drilling and Remarks:

7" (02684)267 1/2' / 5" Per line@ 282312500 Acid20,065,000 Gas386-RA

RECORD

Cased in. ft.Sand Gas Oil Total Depth 2823

PRODUCTION

1st 24 hrs. Nat. 1st 24 hrs. after shot Gas Cu. Ft.Dry Hole Abandoned

Date

APR 10 1946

19

S. J. LEWIS

Scout