

NORTH


SOUTH

Rig Up\_\_\_\_\_

Drilling Remarks

•

•

## RECORD

Cased \_\_\_\_\_ in. \_\_\_\_\_ ft.  
Sand \_\_\_\_\_  
Gas \_\_\_\_\_  
Oil \_\_\_\_\_  
Total Depth \_\_\_\_\_

## PRODUCTION

1st 24 hrs. Nat. \_\_\_\_\_  
1st 24 hrs. after shot \_\_\_\_\_  
Gas \_\_\_\_\_ cu. ft. \_\_\_\_\_  
Dry Hole \_\_\_\_\_  
Abandoned \_\_\_\_\_

*Morton*  
 Map No. **KANSAS** Sec. *4* Twp. *34* R. *39<sup>w</sup>*  
 Well No. *2 - Armstrong* Farm  
*Argus Gas* Company


\_\_\_\_\_ Ft. from N. Line

*1320* Ft. from S. Line

\_\_\_\_\_ Ft. from E. Line

*1320* Ft. from W. Line

*1930*

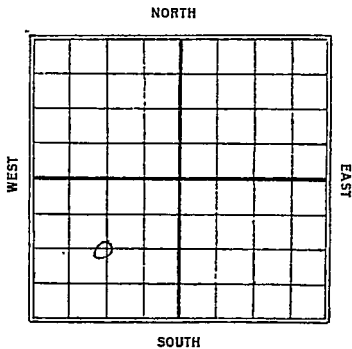

| Date        | REPORT                 |
|-------------|------------------------|
| <i>4/23</i> | <i>Loc.</i>            |
| <i>4/30</i> | <i>Rigging up</i>      |
| <i>5/7</i>  | <i>Spud</i>            |
| <i>5/14</i> | <i>Relg 1400'</i>      |
| <i>5/21</i> | <i>" 2105'</i>         |
| <i>5/28</i> | <i>" 2310'</i>         |
| <i>6/4</i>  | <i>8" - 2550' Rust</i> |
| <i>6/11</i> | <i>J</i>               |
| <i>6/18</i> | <i>Sand 2550-2880</i>  |
|             | <i>TD 2880</i>         |
|             | <i>12 M gas</i>        |
|             | <i>Comp.</i>           |

*Morton*  
Map No. **KANSAS** Sec. *4* Twp. *34* R. *37W*

Well No. *2. Armstrong*

*Argus Gas* Company

Contractor


## SECTION PLAT

Ft. from N. Line

*1320* Ft. from S. Line

Ft. from E. Line

*1320* Ft. from W. Line

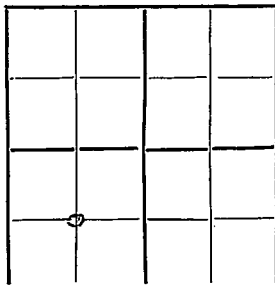

## FIRST REPORTS

Location *✓*

Rig up

Drilling and Remarks:

## RECORD

Cased \_\_\_\_\_ in., \_\_\_\_\_ ft.

Sand \_\_\_\_\_

Gas \_\_\_\_\_

Oil \_\_\_\_\_

Total Depth \_\_\_\_\_

## PRODUCTION

1st 24 hrs. Nat. \_\_\_\_\_

1st 24 hrs. after shot \_\_\_\_\_

Gas \_\_\_\_\_ Cu. Ft.

Dry Hole \_\_\_\_\_

Abandoned \_\_\_\_\_

Date

192

**S. J. LEWIS** Scout


Map No. **KANSAS** Sec. 4 Twp. 34 R. 29 N

Well No. 2 Armstrong

Argus Gas Company

Contractor

## SECTION PLAT

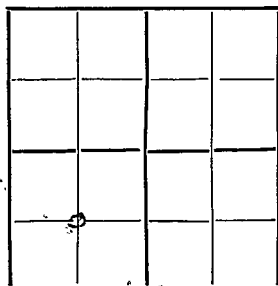

..... Ft. from N. Line

1320 Ft. from S. Line

..... Ft. from E. Line

1320 Ft. from W. Line

COMPLETED

Location.....

Rig up.....

Drilling and Remarks:

12 M Gas

## RECORD

Cased..... in., ..... ft.

Sand 2550-2880

Gas.....

Oil.....

Total Depth 2880

## PRODUCTION

1st 24 hrs. Nat.....

1st 24 hrs. after shot.....

Gas..... Cu. Ft.

Dry Hole.....

Abandoned.....

Date

JUN 18 1930

S. J. LEWIS Scout