


Minton
 Form 51-531-2-29-34703
 Map No. **KANSAS** Sec. 4 Twp. 34 R. 39w
 Well No. 1- St. Mangells Farm
Argus Gas Company

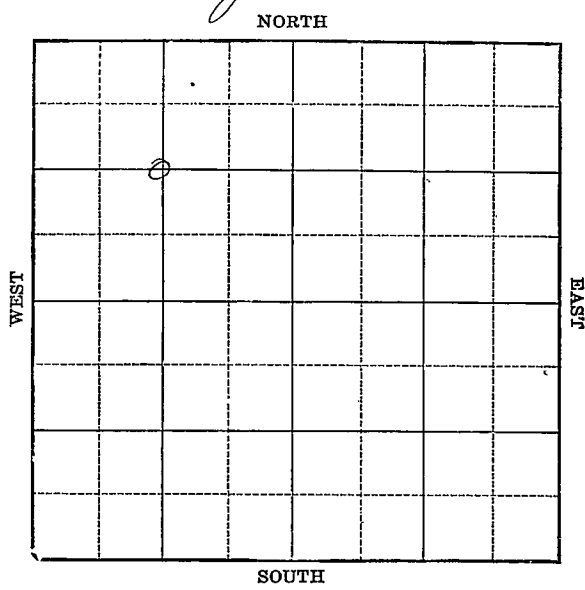

Location _____

Drilling Remarks _____

Rig Up _____

Drilling Remarks _____

RECORD

Cased _____ in. _____ ft.

Sand _____

Gas _____

Oil _____

Total Depth _____

PRODUCTION

1st 24 hrs. Nat. _____

1st 24 hrs. after shot _____

Gas _____ cu. ft.

Dry Hole _____

Abandoned _____

Map No. KANSAS Sec. 4 Twp. 34 R. 39^W
Well No. 1 - H. Mangells Farm

NORTH


1320 Ft. from N. Line

Ft. from S. Line

Ft. from E. Line

1320 Ft. from W. Line

1930

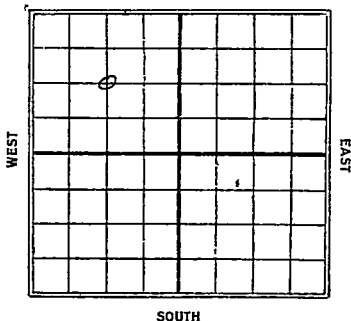

Date /

REPORT

5/21 - Loc.
6/28 —
6/4 Bldg. rig
6/11 Rign up
6/18 Hdg 1880'
6/25 Rust 2592'
7/2 f
7/9 Sand 2592-2851
JD 2851
8 ft gas
Comp.

Morton
Map No **KANSAS** Sec. 4 Twp. 34 R. 39W

Well No. 1 W. Mansella

Argue Gas Company

Contractor


SECTION PLAT

1320 Ft. from N. Line

..... Ft. from S. Line

..... Ft. from E. Line

1320 Ft. from W. Line

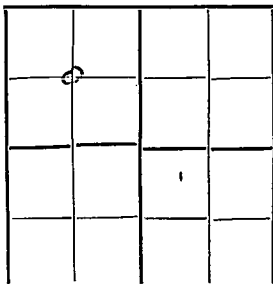

FIRST REPORTS

Location ✓

Rig up

Drilling and Remarks:

RECORD

Cased in., ft.

Sand

Gas

Oil

Total Depth

PRODUCTION

1st 24 hrs. Nat.

1st 24 hrs. after shot

Gas Cu. Ft.

Dry Hole

Abandoned

Date

MAY 21 1930

192

S. J. LEWIS Scout

Map No. **KANSAS** Sec. 4 Twp. 34 R. 39 W

Well No. 1st. Mangels

Argus Gas. Company

Contractor


SECTION PLAT

1320 Ft. from N. Line

..... Ft. from S. Line

..... Ft. from E. Line

1320 Ft. from W. Line

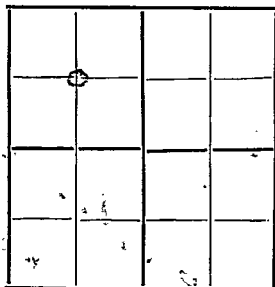

COMPLETED

Location

Rig up

Drilling and Remarks:

S M Gas

RECORD

Cased in., ft.

Sand 2592 - 2851

Gas

Oil

Total Depth 2851

PRODUCTION

1st 24 hrs. Nat.

1st 24 hrs. after shot

Gas Cu. Ft.

Dry Hole

Abandoned

Date

JUL 9 1932

S. J. LEWIS Scout