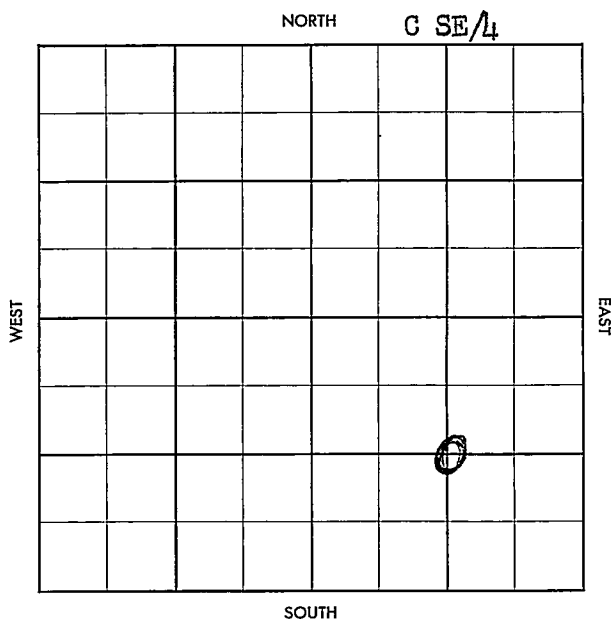


Morton

KANSAS

SECTION 4 TOWNSHIP 34 RANGE ~~###~~ 41WWELL NO. #1-4 KnellerCOMPANY Panhandle Eastern

County Morton

Elev. _____

Sec. 4Twp. 34Rge. 41WCompany Panhandle EasternFarm Name KnellerNo. 1-4

TOPS

DEPTH

LOG

DATUM

Anb.

Tp.

H.

Tr.

Dg.

Bl.

L.

K.C.

B.K.C.

Ce.

C.

M.

M.

K.

Mz.

Mq.

V.

S.

S.

A.

R.

Pe.

G.

G.

T.D.

Loc. in Sec. _____

C SE/4

Geol. _____

Contr. _____

Pool _____

Hugoton

JUN 12 '57

FIRST REPORT

Date Comm. 6-4-577" @ 633/175, stuck @ 136534

County London Elev. 3381Sec. 4 Twp. 34 Rge. 41WCompany Panhandle EasternFarm Name Kneller No. 1-4


TOPS	DEPTH	LOG	DATUM
Anb.			
TP.			
H. <u>KPI</u>		<u>2097</u>	
Tr. <u>WFD</u>		<u>2172</u>	
Dg.			
Bl.			
L.			
K.C.			
B.K.C.			
Ce.			
C.			
M.			
M.			
K.			
Mz.			
Me.			
V.			
S.			
S.			
A.			
R.			
PE.			
G.			
TD.	<u>2275</u>		

Loc. in Sec. C SE/4

Geol. _____

Contr. _____

Pool _____

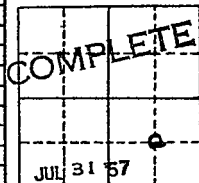HugotonDate Comm. 6-4-577" @ 633/175, stuck @ 1365 JUN 19 571765 " 57 4 1/2 @ 2261/100RUCT JUL 2 57 CO 2256 40/2205-15 N.S. 1 1/2 @ 10 65 wph50d CO 24/2186-92 12/2175-78 32/2159-67 12/2153-561 9a 416 MCLF JUL 10 57 52/2134-47 36/2114-23 1 9a 268MCLF 1 1/4 9a 388 MCLF FRLC

300 Gwph
ga 2 Mill⁺ PB 2172
(wet) PB 2128 JUL 17 57 ga
1.194 + 56 GSWPL PBTD
2150 ga @ 3,129 MCFG JUL 24 57
JUL 31 57 ga 3,129 MCFG PD
complete.