
KANSAS CORPORATION COMMISSION

11-34-41W

WELL RECORD

(Mail to Kansas Geological Survey, 4150 Monroe Street, Wichita, Kansas 67209)

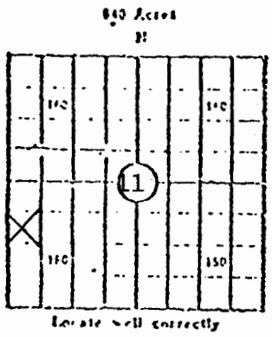

Lease Name: Eagley A Well No. 3
Well Located: 1650'FSL 330'FWL
SEC. 11 TWP. 34 RGE. 41W
Operator: Cities Service Company
Address: 3545 N. W. 58th St., Oklahoma City, OK 73112
Elevation: Ground 3393 D.F. 3402 K.B. 3403
Type Well: (Oil, gas, dry hole) Dry Hole

Drilling Commenced: 1-8 19 78 Drilling Completed: 1-30 1978
Well Completed: 2-2 19 78 Total Depth
Initial Production:

Casing Record

Size: 8-5/8 Set at 1506 Size: Set at - - -
Size: Set at Size: Set at

Liner Record

Size: Set from To

Cementing

Casing Size	Sacks	Type Cement and Additives
8-5/8	600 sx	50/50 Pozmix 2/2% CaCl, 2% Gel, ½# Flocele
	100 sx	60/40 Pozmix w/3% CaCl, ¼# Flocele

Perforations

Formation	Perforated Interval and Number Shots

Electric Log Run. (Show type log and depths covered)

Dual Induction Laterolog, Compensated Formation Density w/Gamma Ray & Caliper, Compensated Neutron Log from 1503 to 5447'

(Fill in formation and related information on reverse side)

11-34-41W

FORMATION, TESTING AND COMPLETION RECORD

Formation	Top	Bottom	Show Drill Stem Tests, Well Stimulation and Production Tests
Red Bed	0	646	DST #1 (Lansing) 3934-3964
Red Bed & Sand	646	1507	
Red Bed	1507	1694	DST #2 (Topeka) 3180-3230
Red Bed & Anhydrite	1694	2063	
Red Bed & Shale	2063	2363	Logging: Dual Induction Laterolog, Compensated
Shale	2363	2510	Formation Density w/Gamma Ray & Caliper, Compensated
Shale & Lime	2510	2750	Neutron Log from 1503-5447'.
Lime & Shale	2750	4583	
Lime	4583	4624	
Lime & Shale	4624	5465	
Total Depth		5465	

11-34-41W